



Environmental Management & Construction Plan - Notice of Minor Change

Project:	Alle-Catt - NY Wind Project	Case #:	001}	
Location	Allegany, Cattaraugus, and Wyoming County, NY	Change #:	15	
Applicable Certificate	Article 10			
Reference Drawing/Location of Change:	C-135, C-140, C207			
Features Changed: C135- Turn improvement shift directly north C140-Turn improvement radius shift C207-Alternate temporary access. Ag. and Markets Guidelines and Standards will apply to any agricultural impact changes.				
Change Impacts/Benefits	Yes	No	N/A	Description/Notes
Additional Ground Disturbance	✓			C207 requires additional agricultural impacts
Expansion of LOD's		✓		C207 requires additional LOD to work around landowner concrete stormwater apron
Additional Clearing		✓		
Other Impact		✓		
Mitigate/Eliminate impact to other area(s)		✓		
Mitigate/Eliminate impact to wetland(s)		✓		
Mitigate/Eliminate disturbance in other area(s)		✓		
Other Benefit		✓		
Landowner approval (if necessary)	✓			
Rationale for Change: C135-There is an existing elliptical Reinforced Concrete Pipe (RCP) 75" W x 48"H culvert crossing Laidlaw Rd. This shift will eliminate the need to remove/damage existing infrastructure. C140- The transportation company has recommended the radius decrease for deliveries at this location. C207- At the entrance to T-10 the landowner installed a concrete apron that ties into Bray Road and runs approximately 50' into the proposed access road. This infrastructure is in the way of the proposed entrance as approved.				
Approvals	Name (Entity)		Date	
Initiated By:	Ray Yorks		9/30/2025	
Invenergy CM/PM Approval:				
DPS Verbal Approval By:				


DPS Written Approval By:		
Pages/Pictures/Drawings Attached (Quantity and Description): 1. Redline C135 2. Proposed C135 3. Redline C140 4. Proposed C140 5. Redline C207 6. Proposed C207		

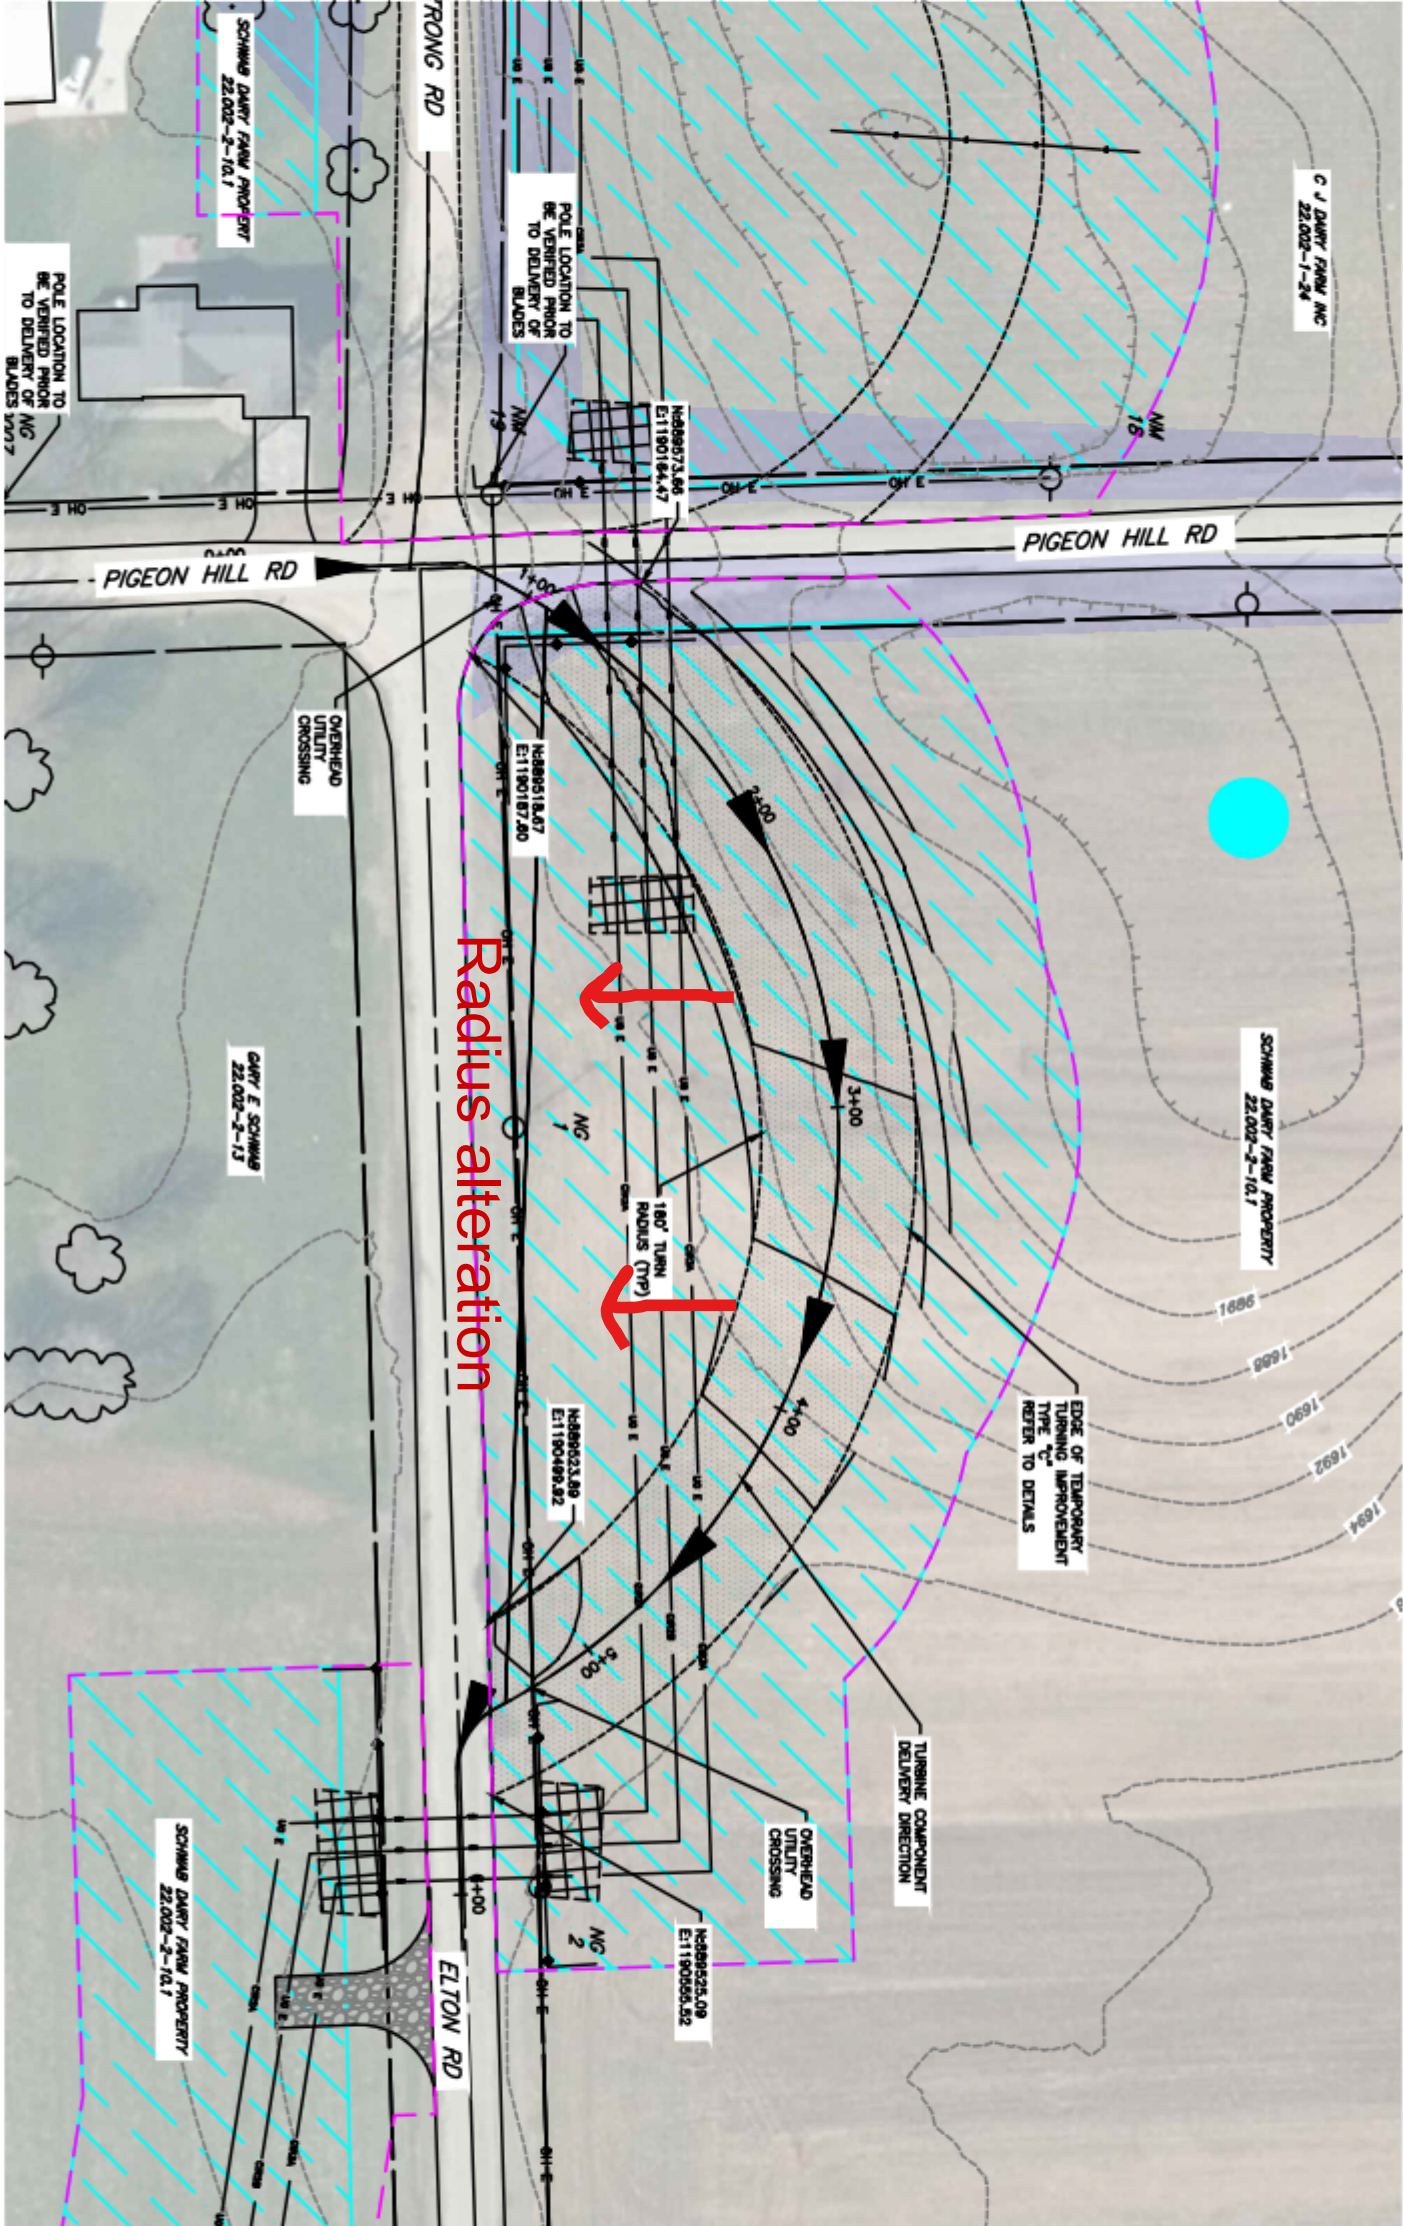


PLAN VIEW
SCALE: 11X17 1"=60'
22X34 1"=30'

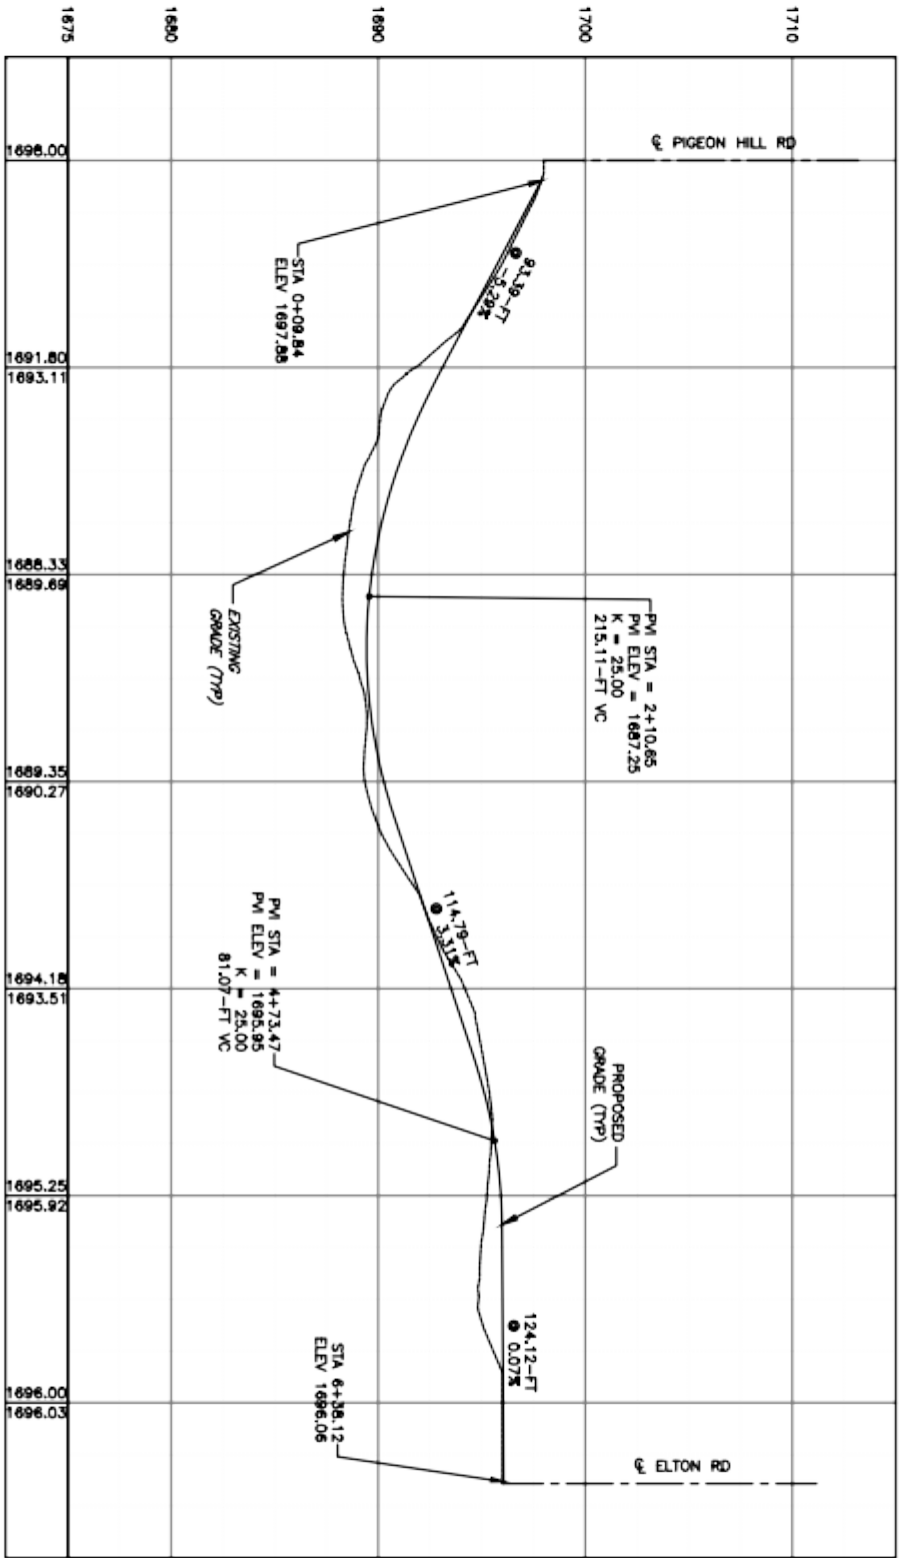


PROFILE VIEW
SCALE: 11X17 1"=120'
22X34 1"=60'

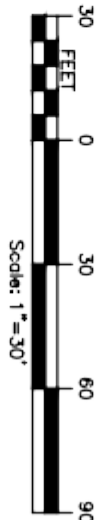

NOTES:
1. TEMPORARY IMPROVEMENT TYPICAL SECTION SHALL BE AS PER REQUIREMENTS OF H-205 LOADING.

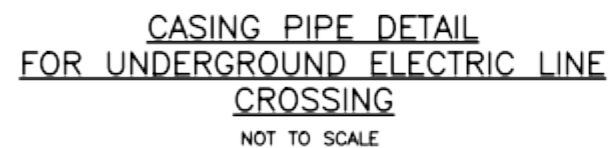


APPLICANT NAME: ALLE-CATT WIND ENERGY, LLC
JOINT APPLICANT NAME: THE WESSON GROUP, LLC
JOINT APPLICANT CONTACT: SETH BLY
JOINT APPLICANT EMAIL ADDRESS: SBLY@TWG.US.COM

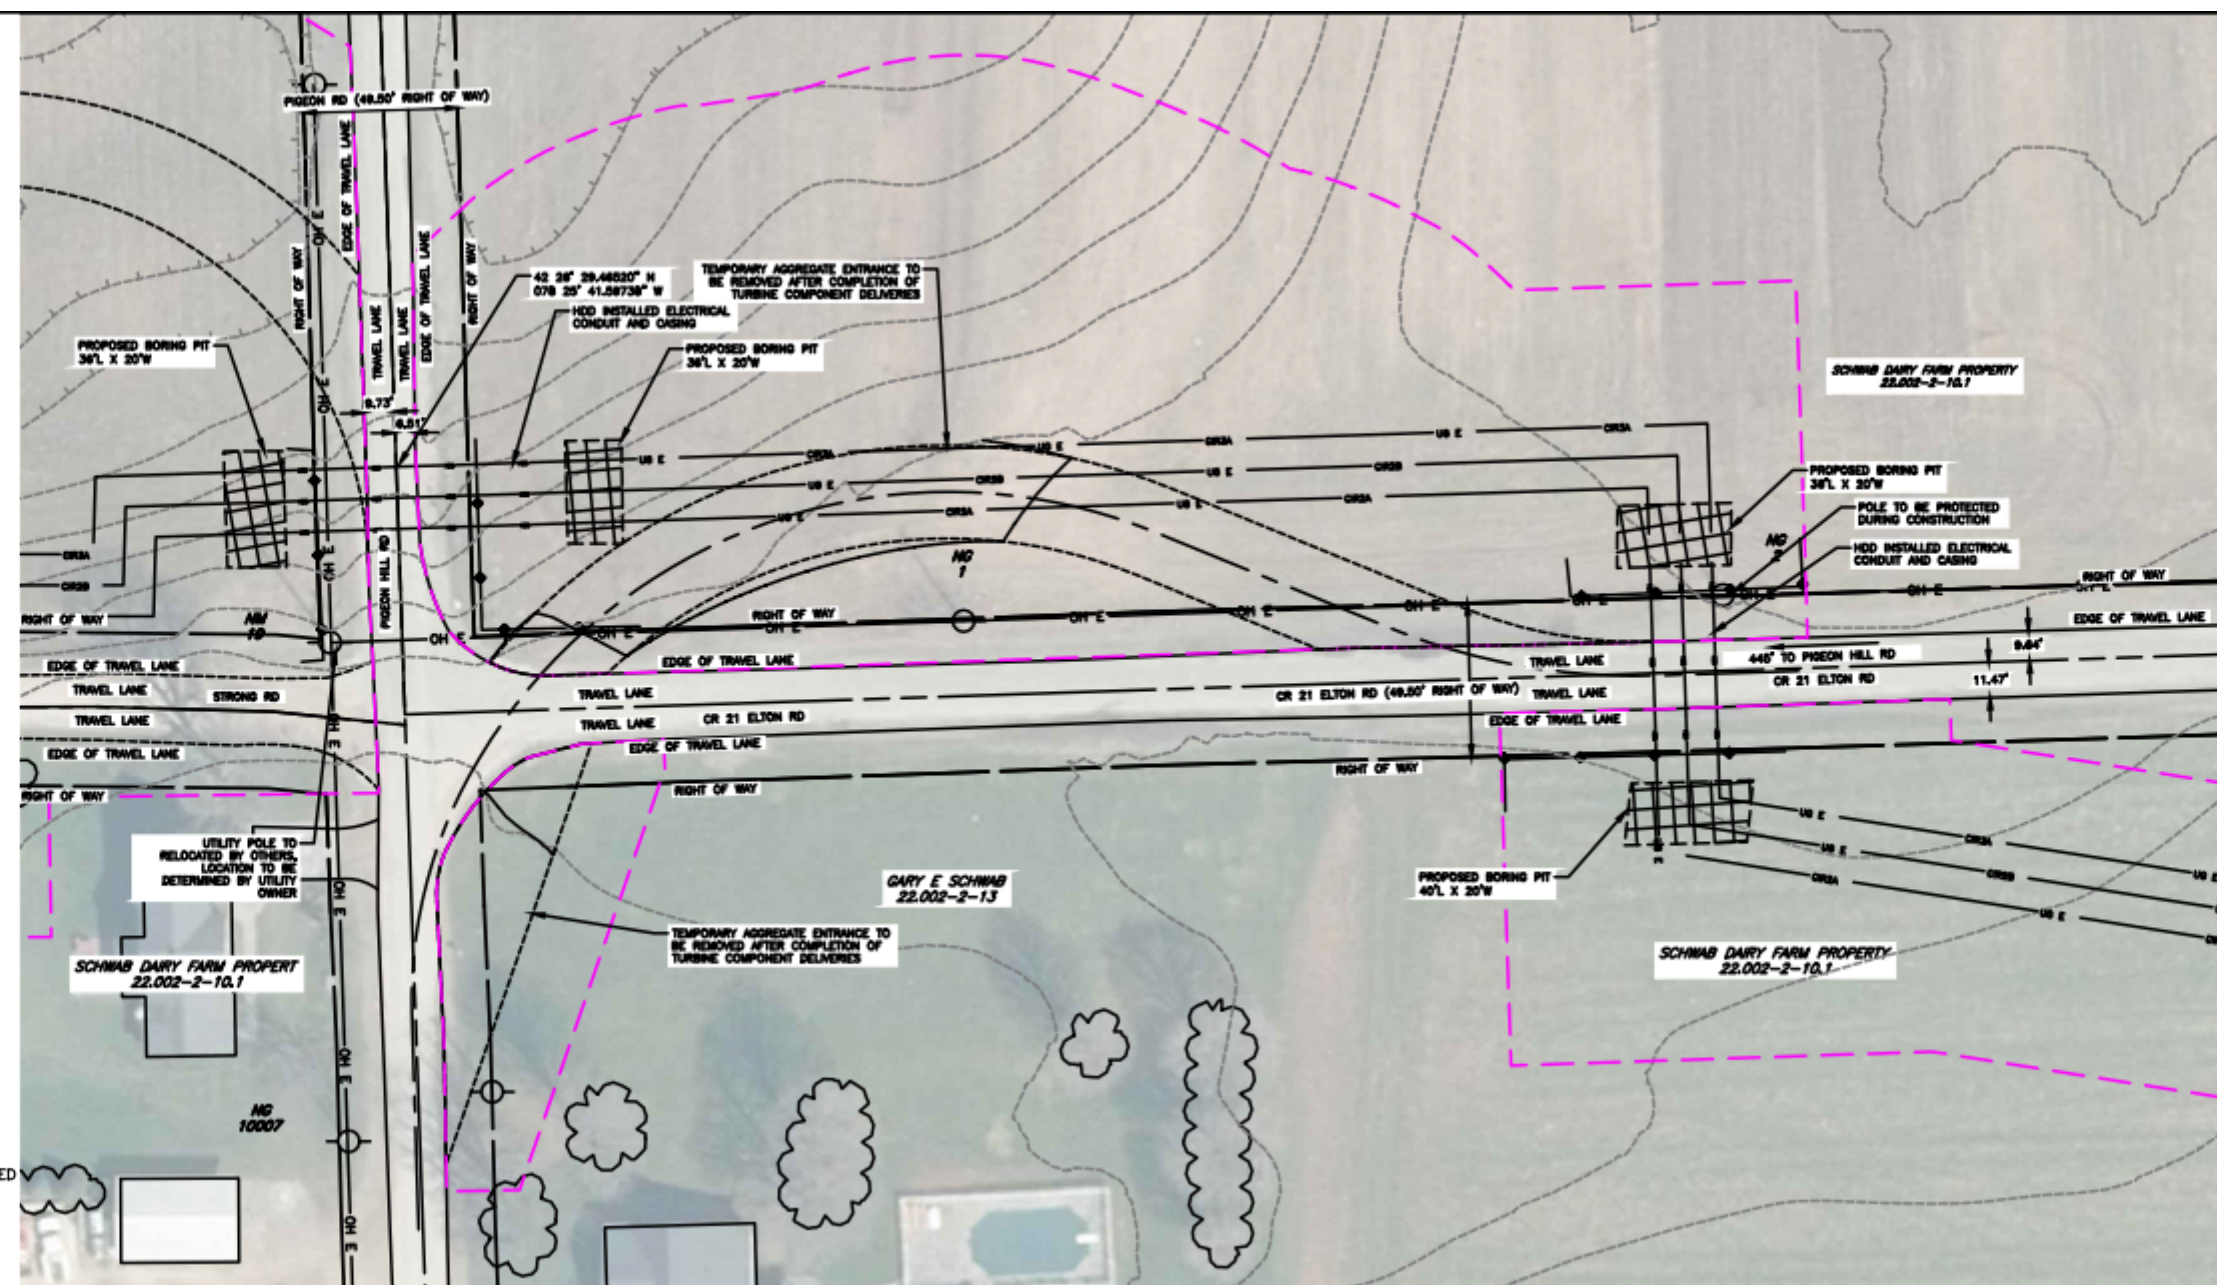

PLAN VIEW



SCALE: 11X17 1"=120'
22X34 1"=60'

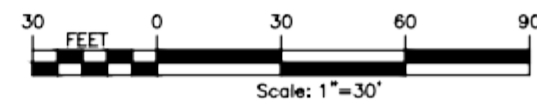



EXISTING LEGEND

	CONTOUR, MAJOR
	CONTOUR, MINOR
	ELECTRIC LINE, OVERHEAD
	GAS, UNDERGROUND
	POLE, WITH UTILITY
	PROPERTY LINE (APPROX.)
	PROPERTY LINE (SURVEYED)
	RIGHT OF WAY LINE
	DELINEATED STREAM
	TREE LINE
	DELINEATED WETLAND
	GUIDERAIL

PROPOSED LEGEND

500 _____	CONTOUR, MAJOR
501 _____	CONTOUR, MINOR
_____ UG E _____ CIR1 _____	UNDERGROUND ELECTRIC COLLECTION (WITH CIRCUIT DESIGNATION)
=====	NEW ACCESS ROAD
_____	LIMIT OF DISTURBANCE
-----	TEMPORARY IMPROVEMENT
	E & S, CONSTRUCTION ENTRANCE
_____ ● _____ ● _____ ● _____	E & S, SILT FENCE
	TREE CLEARING LIMITS
ACCESS ROAD ABBREVIATION	
 CULVERT (H1-1)	PROPOSED PERMANENT CULVERT LAB
	PROPOSED BORING PIT
	JUNCTION BOX

PROJECT ALLECATT WIND FARM ALLECATT WIND ENERGY LLC ALLEGANY, CATTARAUGUS, AND WYOMING COUNTIES, NEW YORK			DRAWN BY C. HARVEY SCALE AS SHOWN	PROJECT NO. 210351 PROJECT MANAGER L. OLIVER	ISSUE DATE 06/2025	COPYRIGHT © 2025 FISHER ASSOCIATES P.E. L.S., L.A. D.F.C.	New York State Education Law Section 1705 requires that it is a violation of the law for any person to knowingly or recklessly falsify or alter any official record, document, or instrument, or to knowingly or recklessly use any falsified or altered record, document, or instrument, for any purpose.	If it has been handled the need of an existing engineering record, drawing, or document, the user must be aware that the user is not to alter or change the date of such drawing, document, or instrument, or to use any falsified or altered drawing, document, or instrument, for any purpose.	REV	DATE	BY

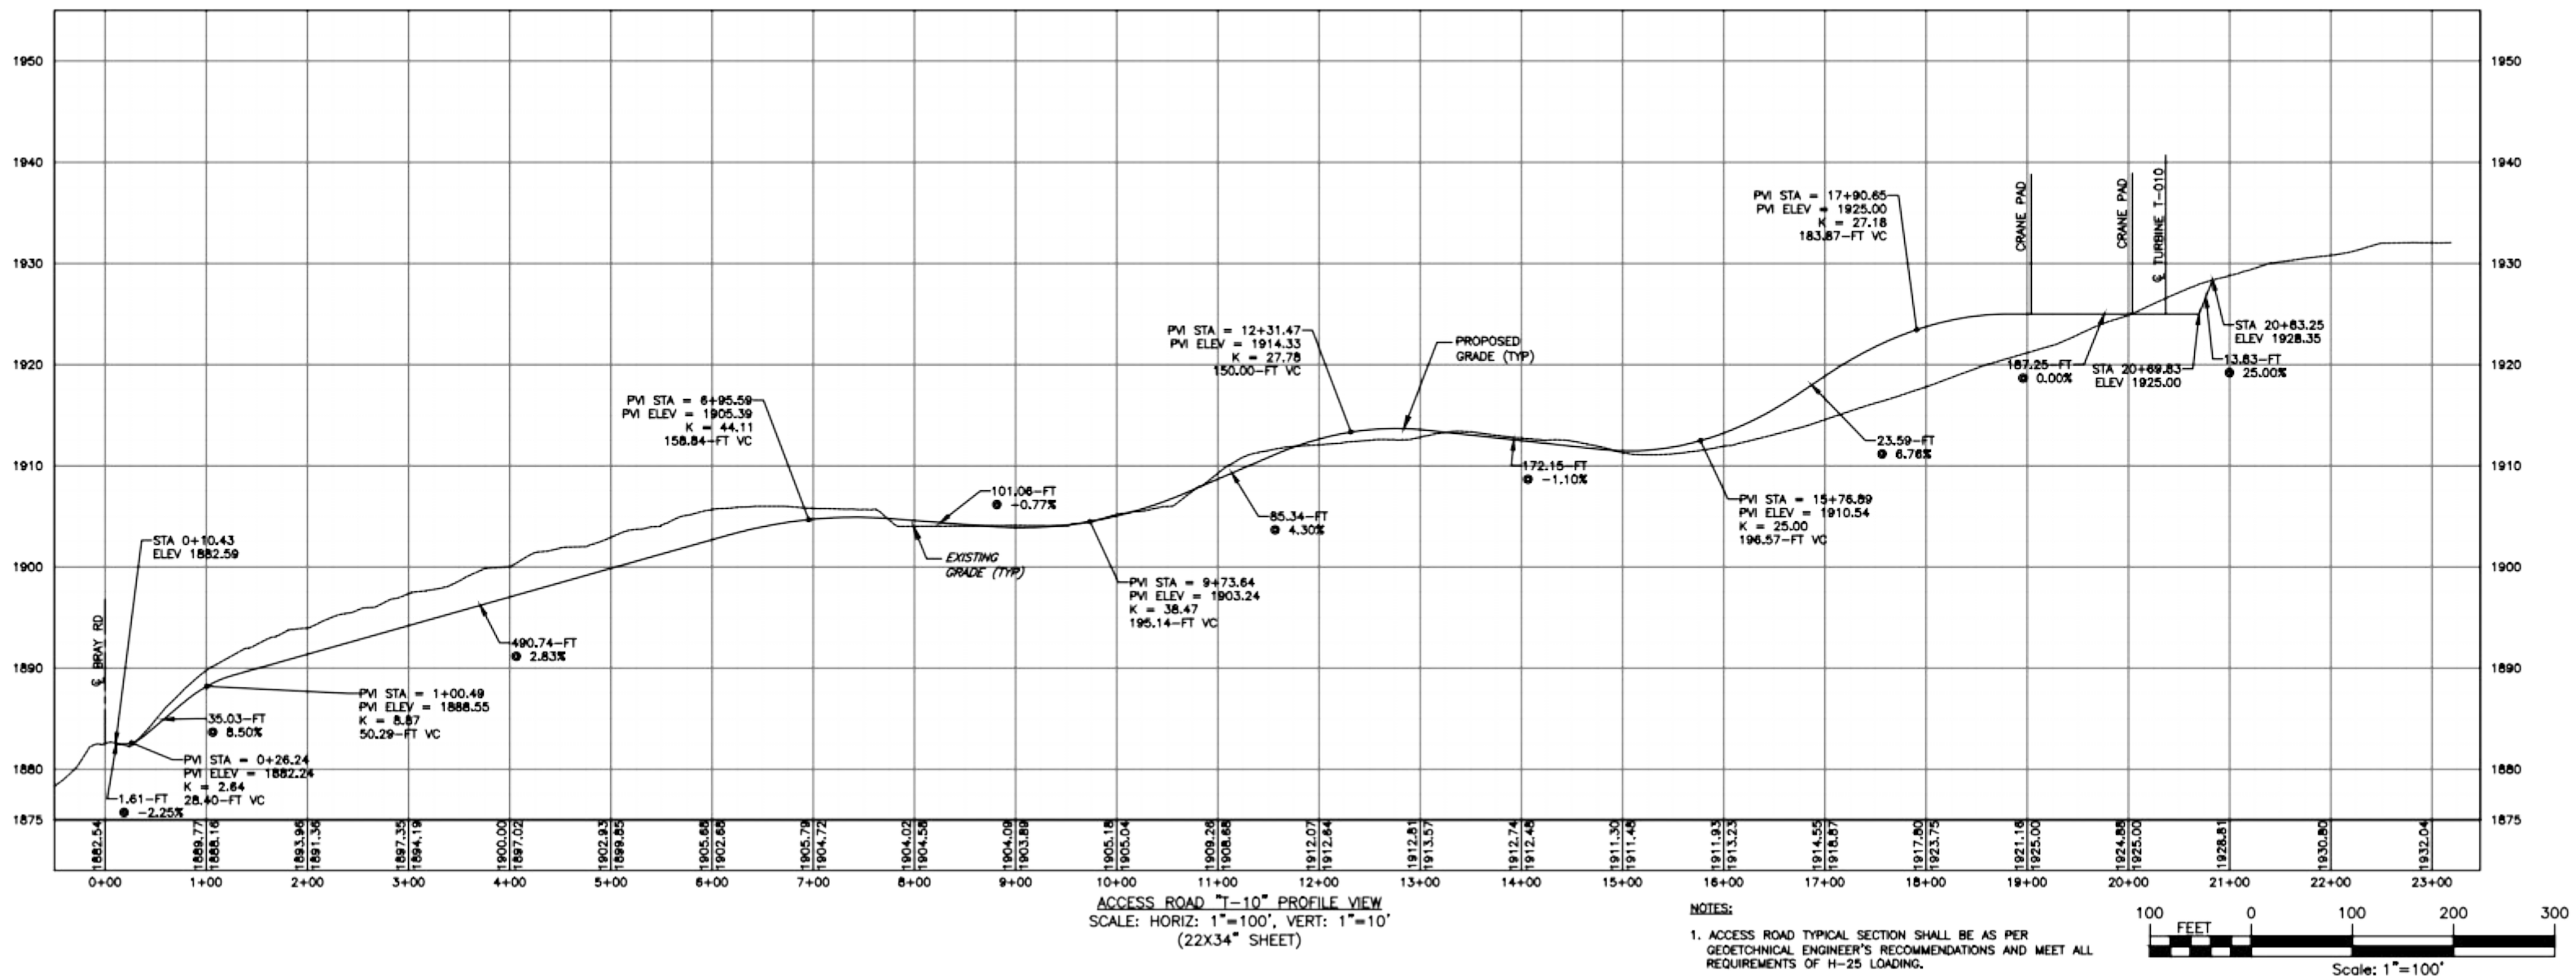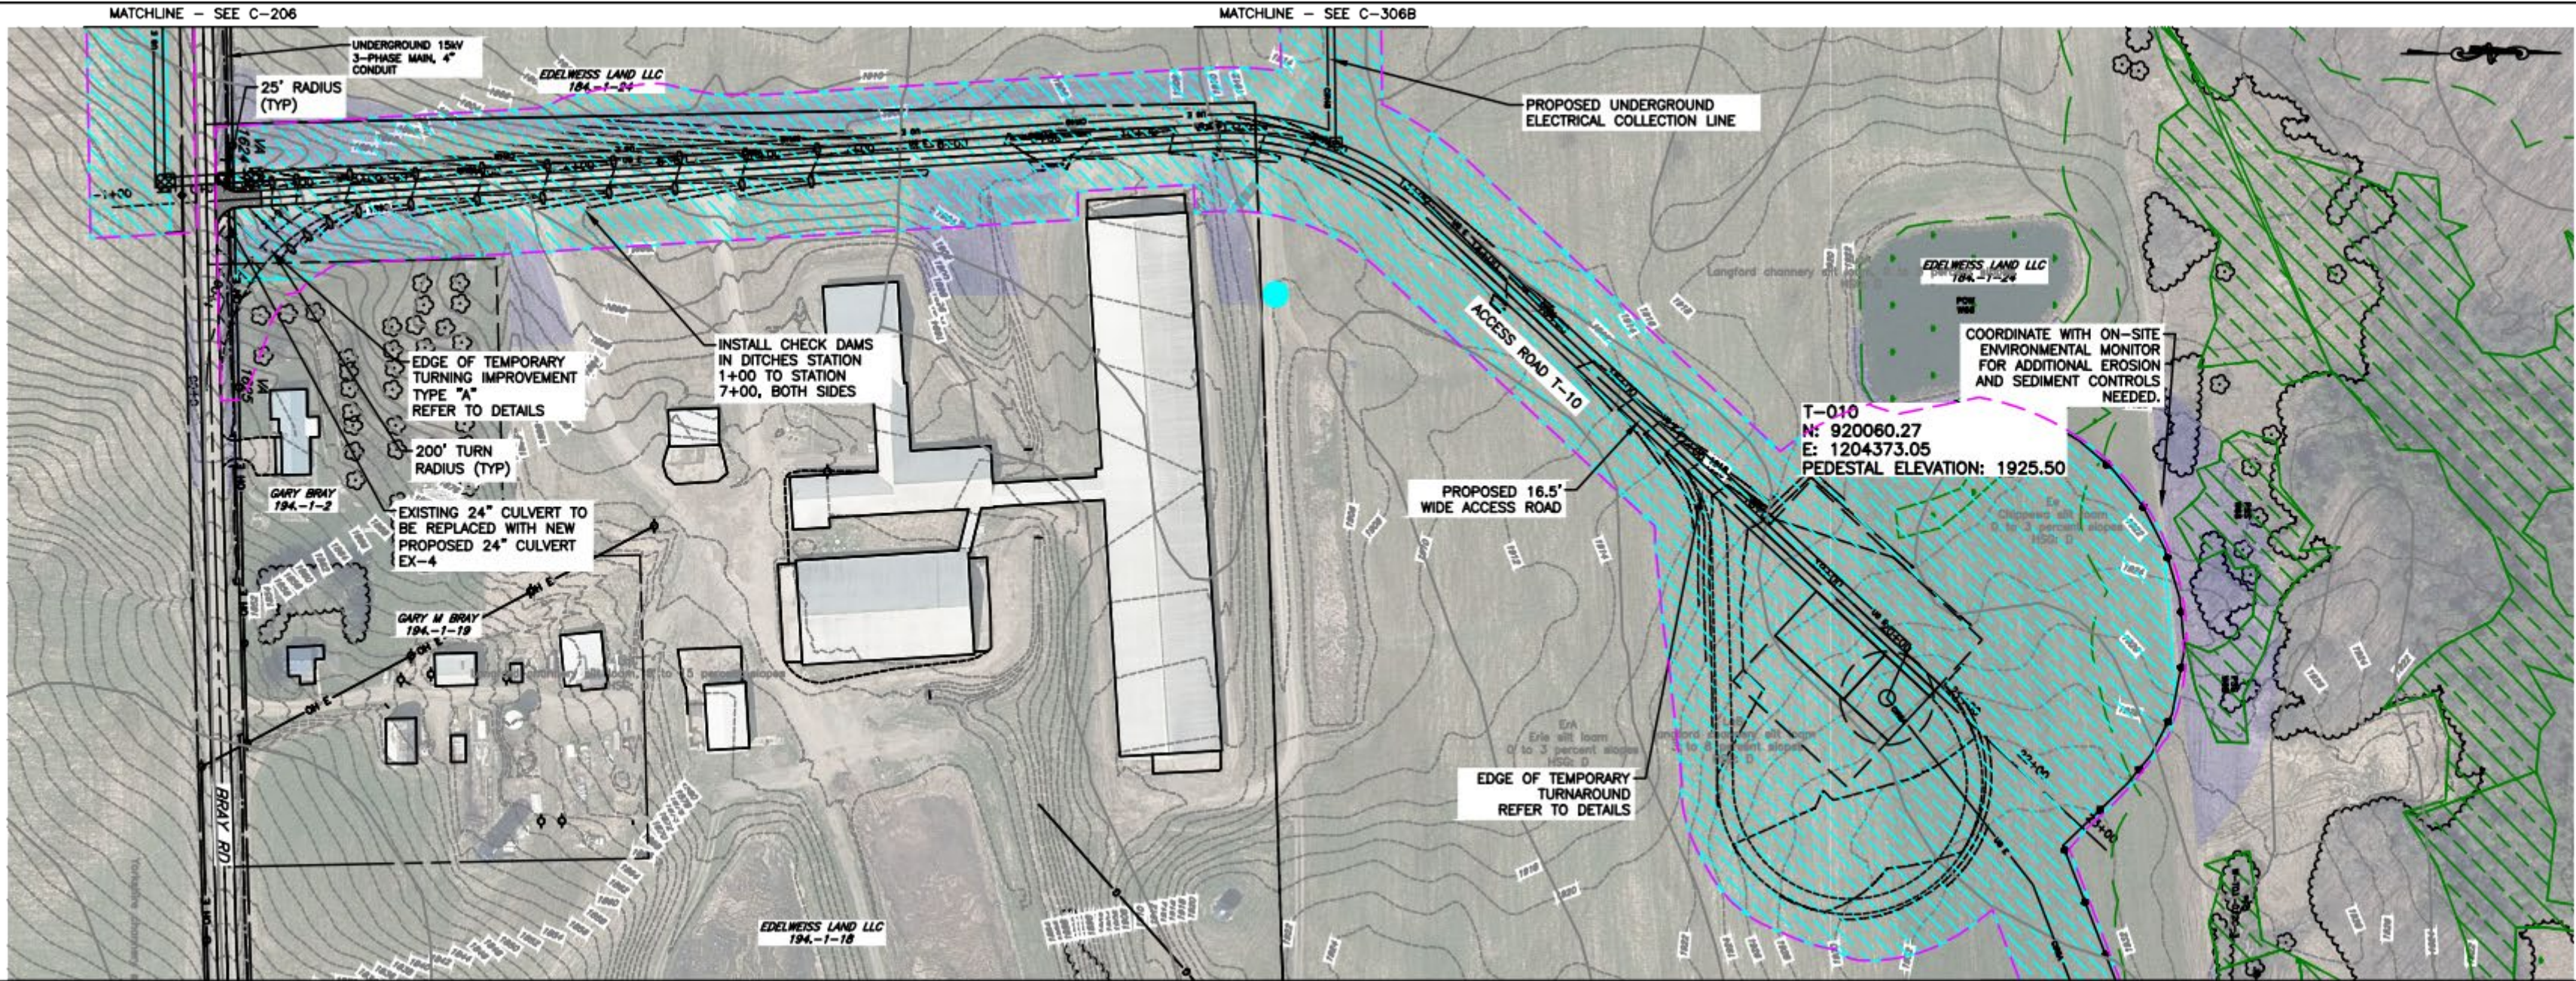

REV	DESCRIPTION	DATE	BY
1			
2			
3			
4			
5			
6			
7			

COPYRIGHT © 2021
FISHER ASSOCIATES
P.E., L.S., D.P.C.

FA PROJECT NO.
210351

PROJECT MANAGER
L. OLIVER

DRAWN BY
C. HARVEY

SCALE
AS SHOWN

ISSUE DATE
05/30/25

NEW YORK STATE
SEAL OF THE ENGINEER
C. HARVEY
194-1-18


Invenergy

PROJECT
ALLE-CATT WIND FARM
ALLE-CATT WIND ENERGY LLC
ALLEGANY, CATTARAUGUS, AND
WYOMING COUNTIES, NEW YORK




TITLE OF DRAWING
ACCESS ROAD T-10 PLAN AND PROFILE

DRAWING NO.
C-207

SHEET 072 OF 248

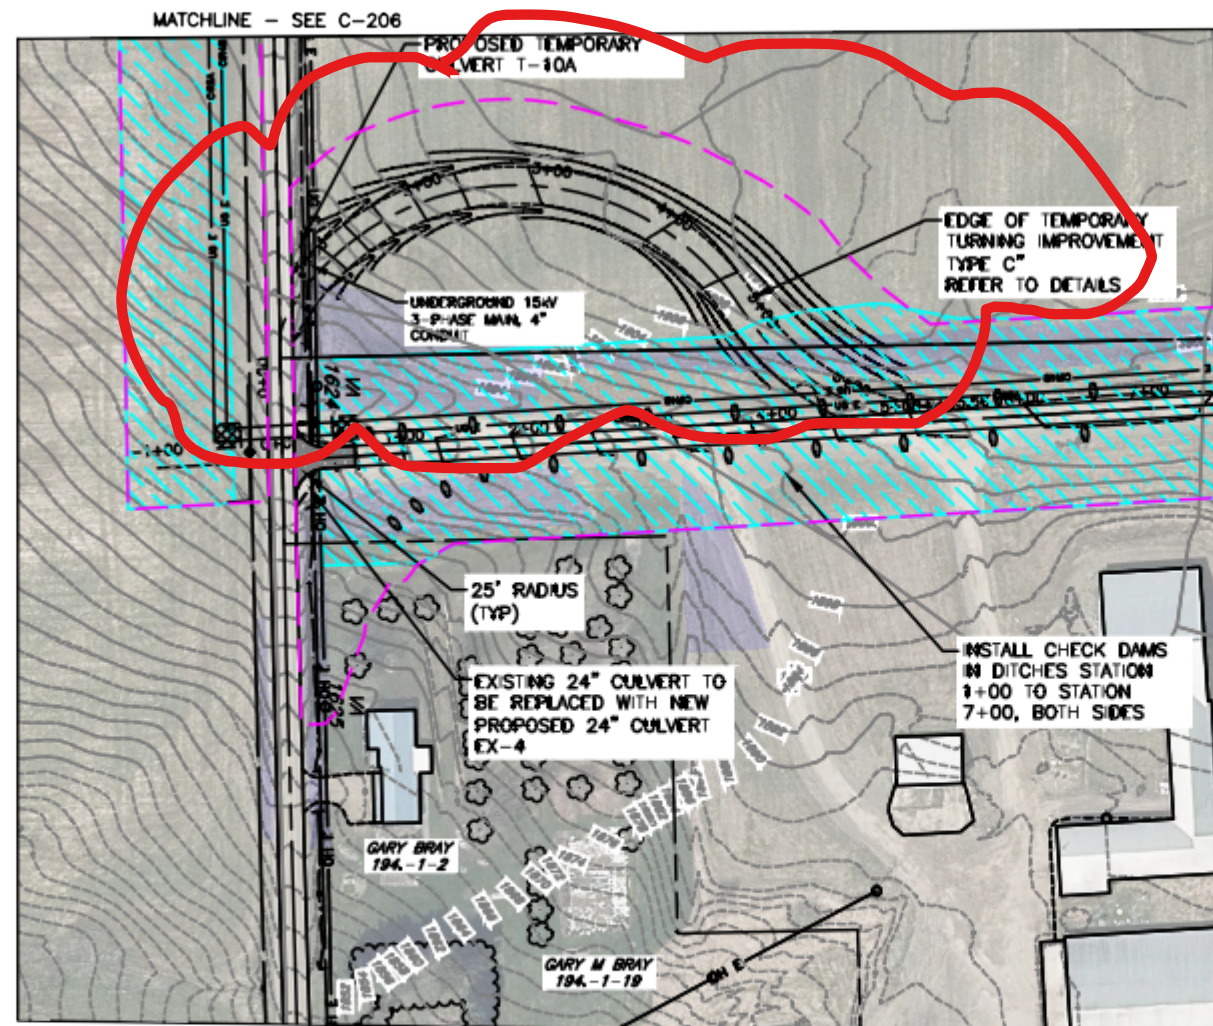

Additional
temp access
to avoid
landowner
infrastructure

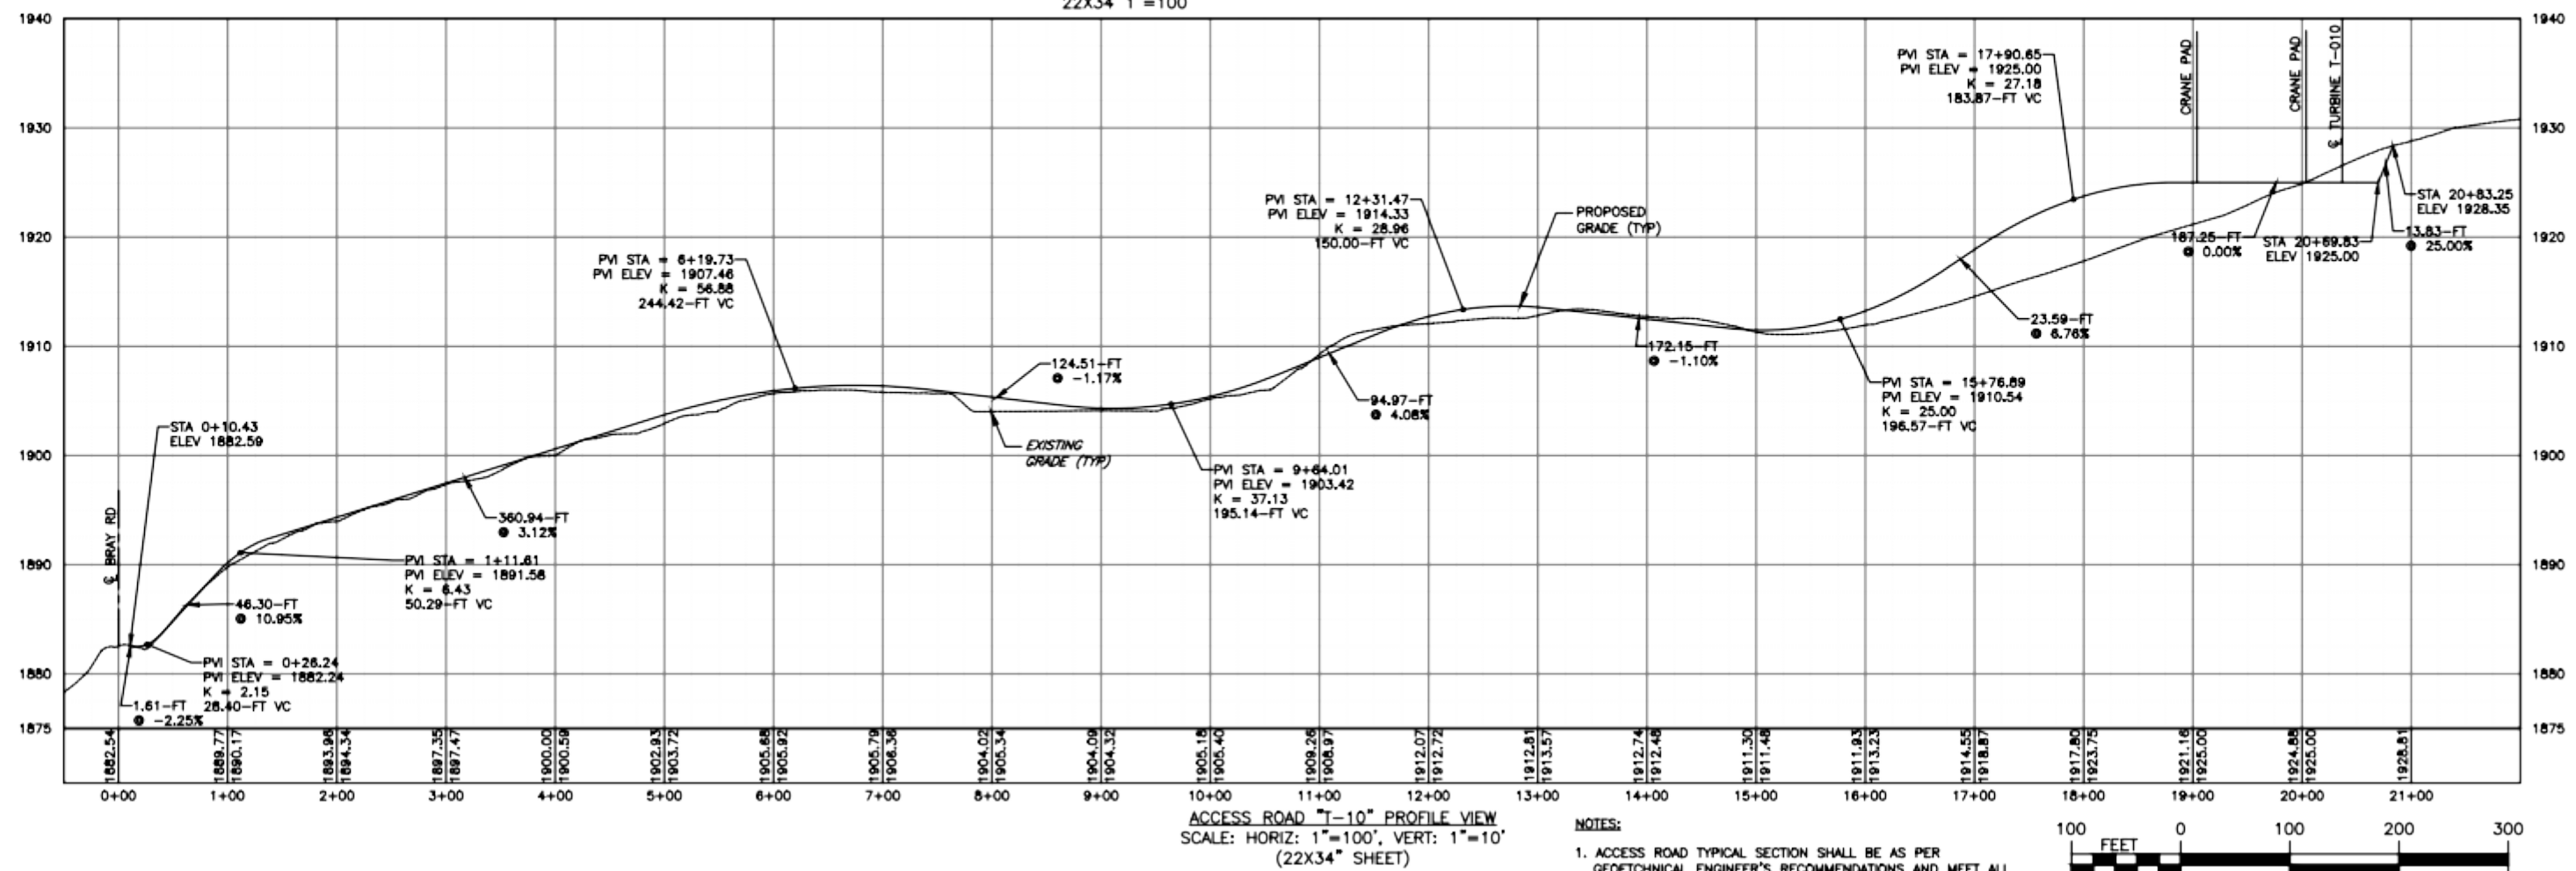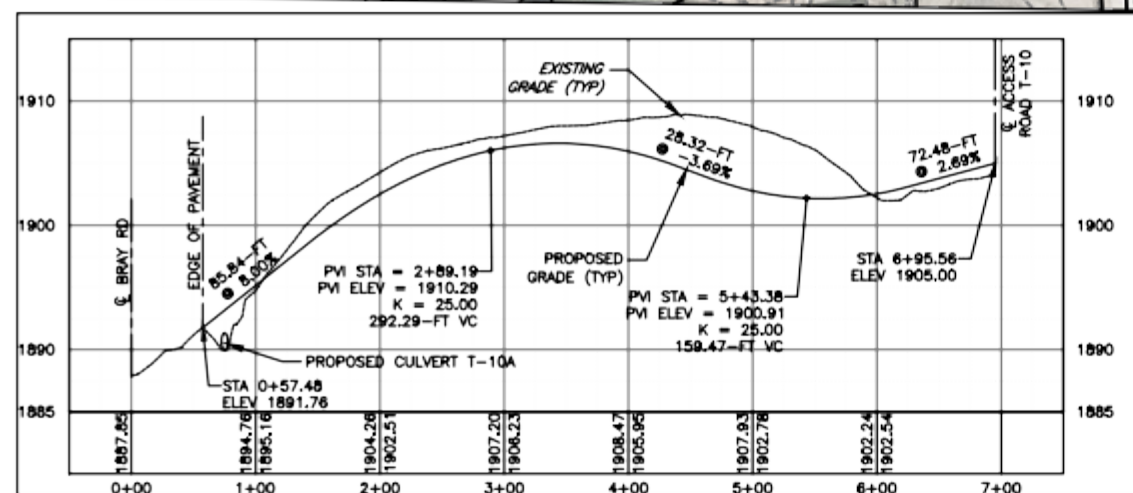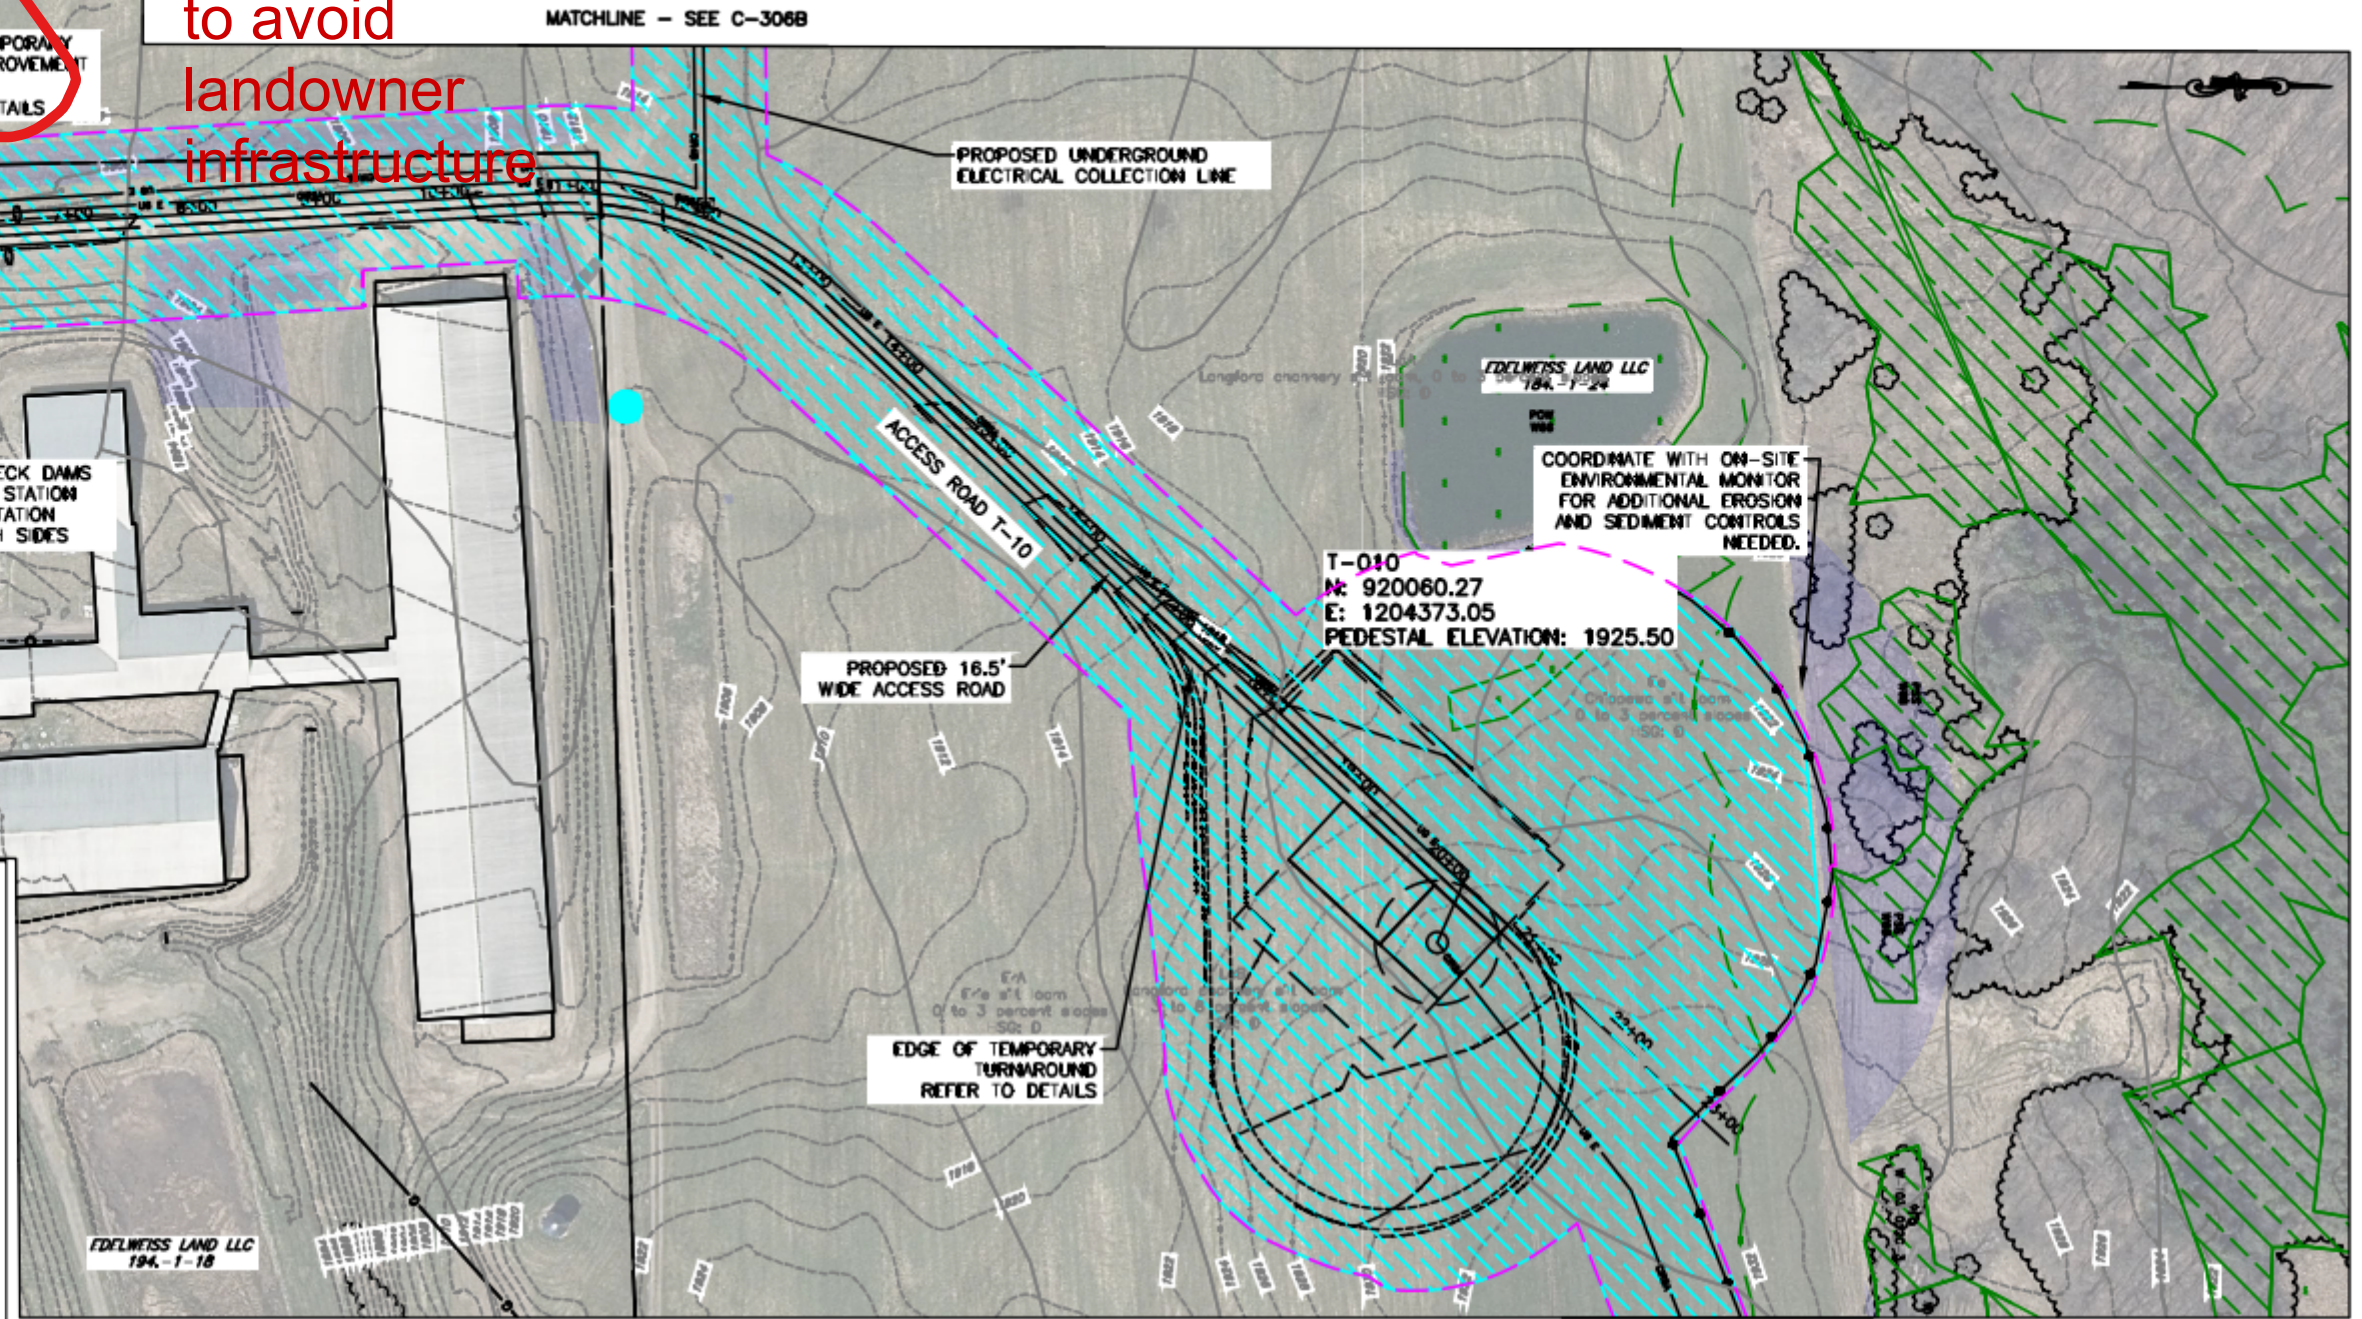

REV	DESCRIPTION	DATE	BY
1			
2			
3			
4			
5			
6			
7			

COPYRIGHT © 2021
FISHER ASSOCIATES
P.E., L.S., D.P.C.

NEW YORK STATE
SEAL OF THE ENGINEER
C. HARVEY
194-1-18

PROJECT NO.
210351
PROJECT MANAGER
L. OLIVER
DRAWN BY
C. HARVEY
SCALE
AS SHOWN
ISSUE DATE
05/30/25

Invenergy

PROJECT
ALLE-CATT WIND FARM
ALLE-CATT WIND ENERGY LLC
ALLEGANY, CATTARAUGUS, AND
WYOMING COUNTIES, NEW YORK

TITLE OF DRAWING
ACCESS ROAD T-10 PLAN AND PROFILE

DRAWING NO.
C-207

SHEET 072 OF 248