


Environmental Management & Construction Plan - Notice of Minor Change

Project:	Alle-Catt - NY Wind Project	Case #:	001}	
Location	Allegany, Cattaraugus, and Wyoming County, NY	Change #:	14	
Applicable Certificate	Article 10			
Reference Drawing/Location of Change:	C-205, C-257, C-259A			
Features Changed: Invenergy is proposing to shift tower coordinates at the following locations: T-14- 12ft shift east T-57- 6ft shift southwest T-88- 34ft shift west-southwest				
Change Impacts/Benefits	Yes	No	N/A	Description/Notes
Additional Ground Disturbance		✓		
Expansion of LOD's		✓		
Additional Clearing		✓		
Other Impact		✓		
Mitigate/Eliminate impact to other area(s)		✓		
Mitigate/Eliminate impact to wetland(s)	✓			T-88 shift will be to reduce/eliminate wetland impacts.
Mitigate/Eliminate disturbance in other area(s)		✓		
Other Benefit		✓		
Landowner approval (if necessary)			✓	
Rationale for Change: T-14- 12ft shift east; to be further within the FAA "Determination of No Hazard" latitude/longitude bounds T-57- 6ft shift southwest, to improve grading T-88- 34ft shift west-southwest, to reduce wetland impact				
Approvals	Name (Entity)		Date	
Initiated By:	Ray Yorks		9/23/2025	
Invenergy CM/PM Approval:				
DPS Verbal Approval By:				
DPS Written Approval By:				


Pages/Pictures/Drawings Attached (Quantity and Description):

1. Approved EM&CP with Redlines
2. Adjusted EM&CP showing changes

Wind Turbines						
WTG Number	Approximate Distance Change	Reason for Change	Max FAA Approved Tip Height (feet AMSL)	Tip Height (feet AMSL)	Difference in Elevation (feet)	Change in Impacts
14	12 foot shift east	Shifting to be further within the FAA "Determination or No Hazard" boundary	2,556.0	2,546.0	0.0	No changes to temporary or permanent stream impacts, no temporary or permanent change in agricultural impacts that's not anticipated to impede farming operations.
57	6 foot shift southwest	Improve grading	2,508.0	2,500.0	0.0	No changes to temporary or permanent stream impacts, no temporary or permanent change in agricultural impacts that's not anticipated to impede farming operations.
88	34 foot shift west/southwest	Reduce wetland impact	2,660.0	2,650.0	0.0	Reduction in up to 0.2 acres of temporary wetland impact and 0.008 acres of permanent wetland impact, no temporary or permanent change in agricultural impacts.

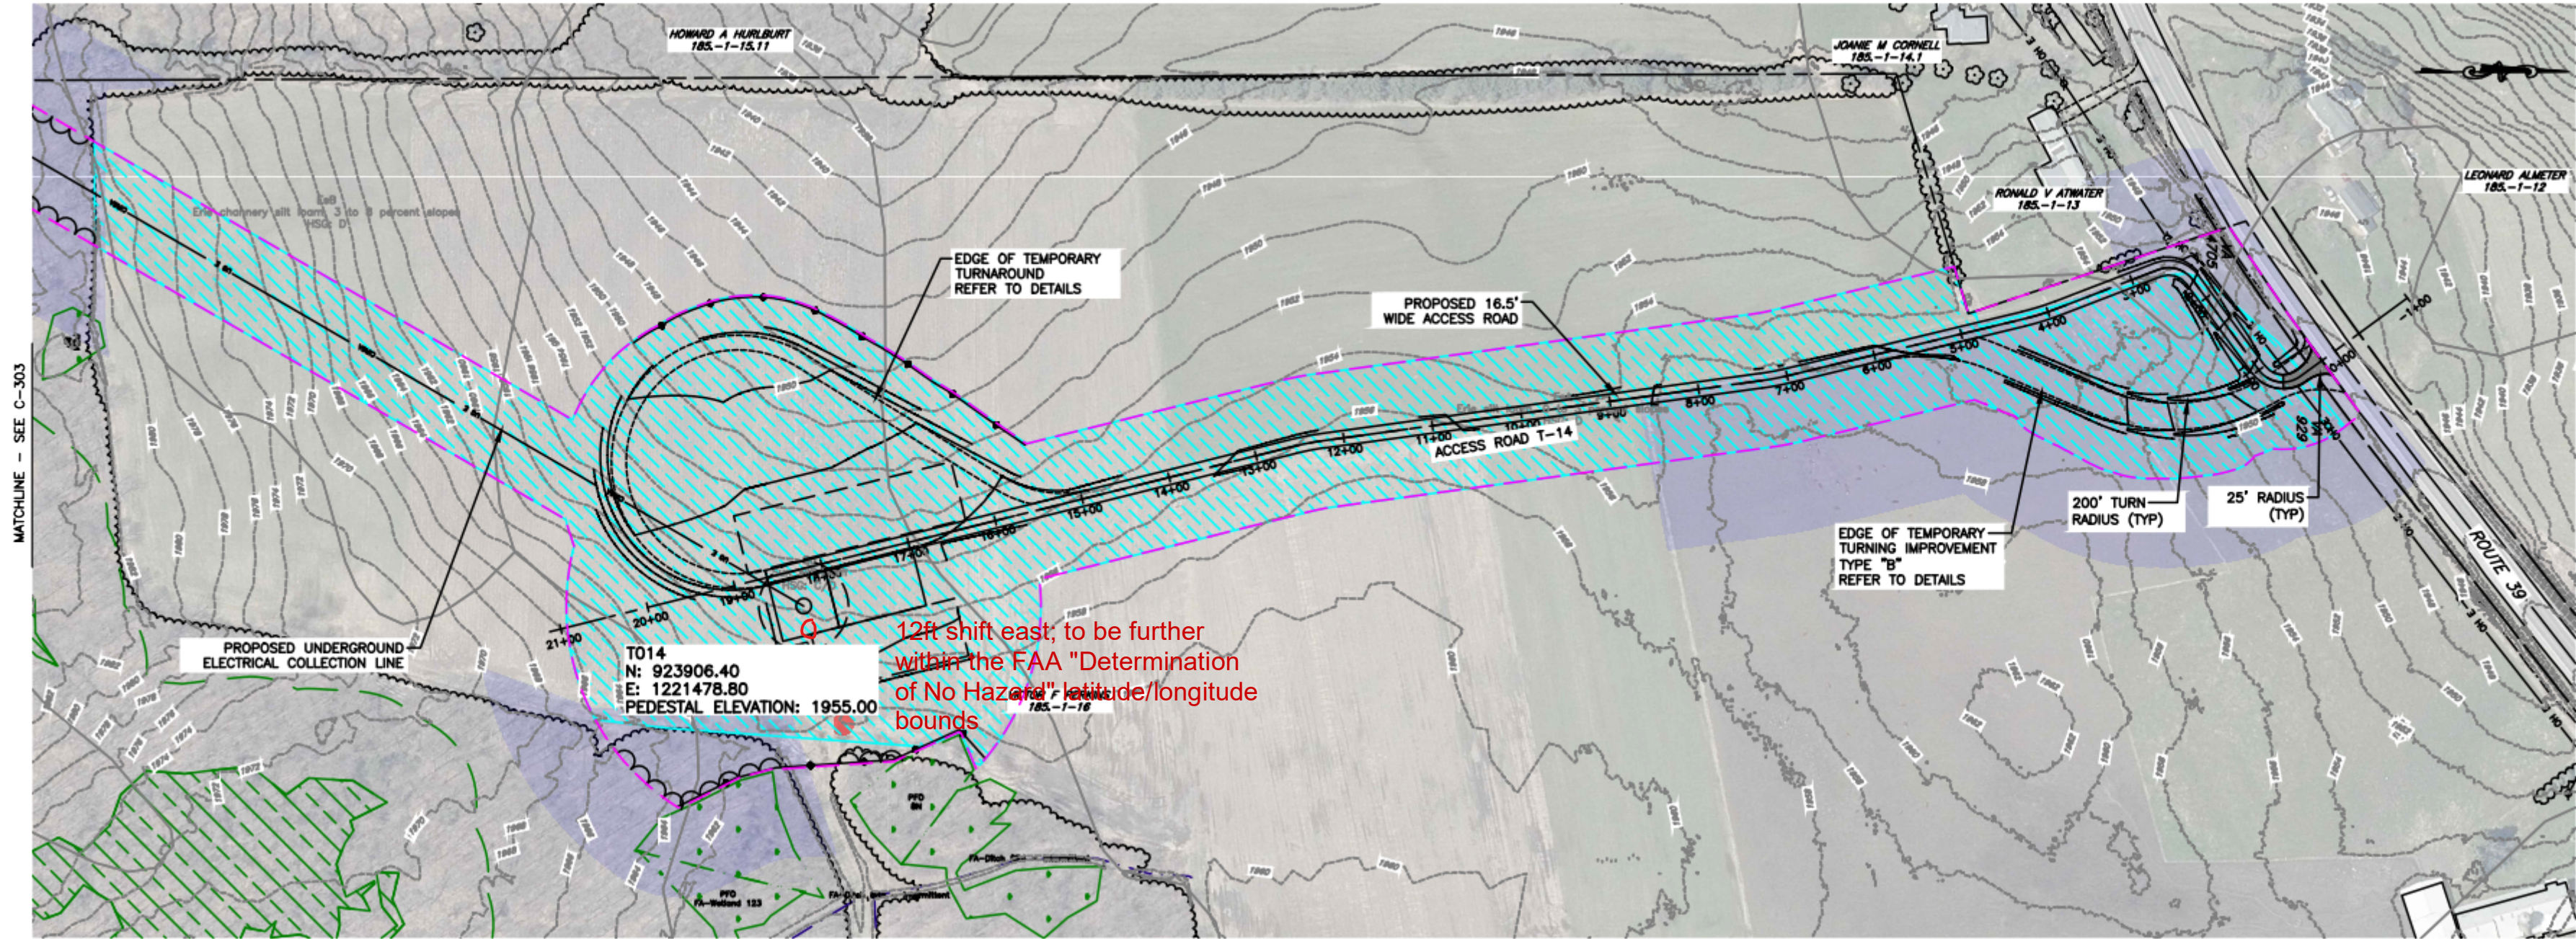


PLAN VIEW
SCALE: 11X17 1"=200'
22X34 1"=100'

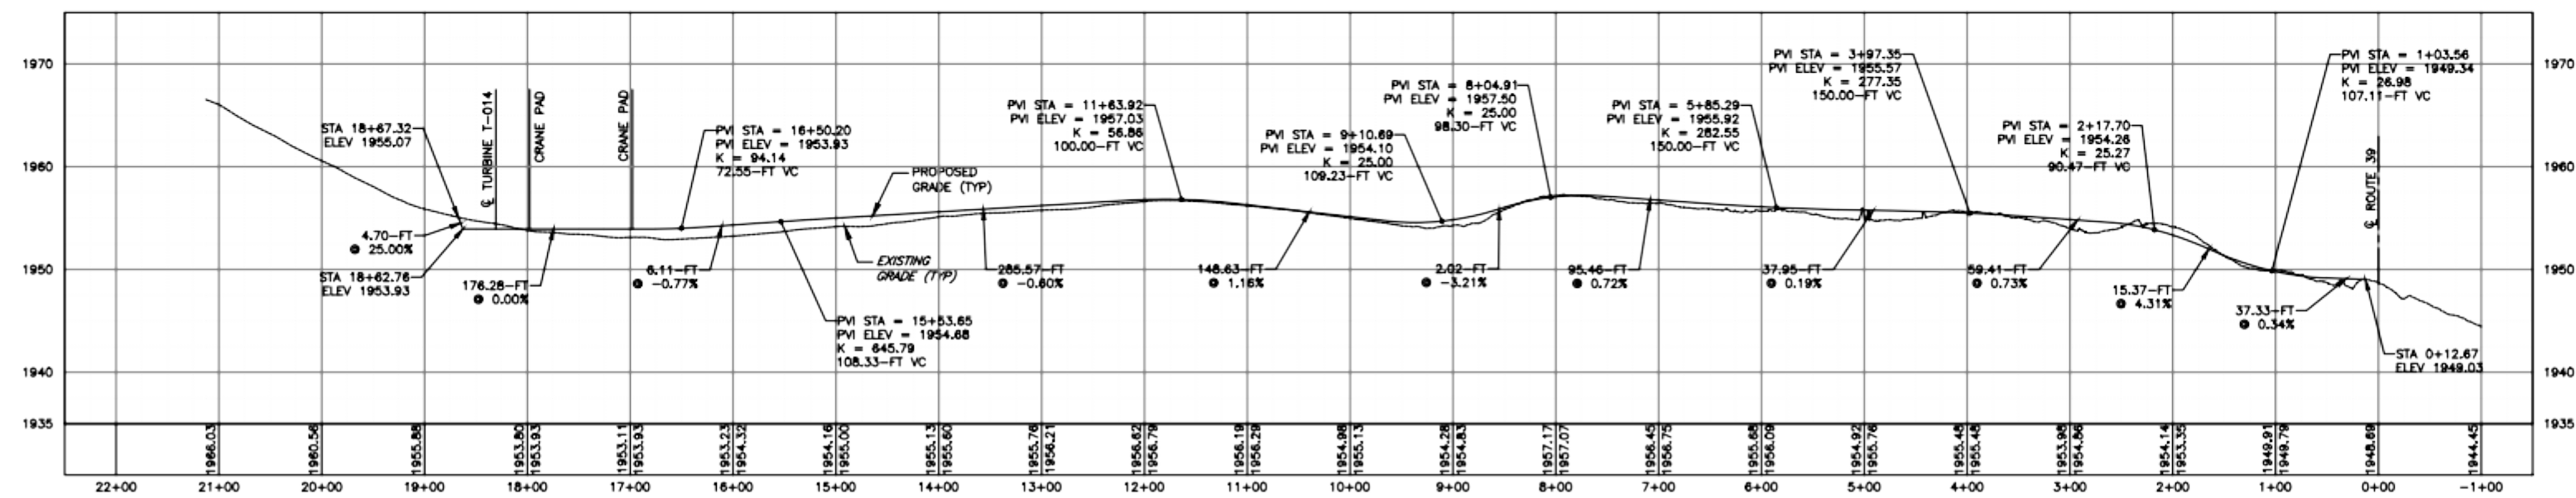

ACCESS ROAD "T-14" PROFILE VIEW
SCALE: HORIZ: 1"=100', VERT: 1"=10'
(22X34" SHEET)

NOTES:

1. ACCESS ROAD TYPICAL SECTION SHALL BE AS PER GEOTECHNICAL ENGINEER'S RECOMMENDATIONS AND MEET ALL REQUIREMENTS OF H-25 LOADING.

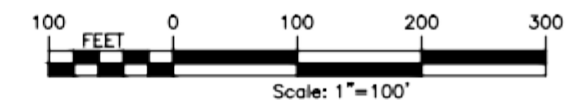

REV	DESCRIPTION	DATE	BY
7			
6			
5			
4			
3			
2			
1			

COPYRIGHT © 2021
FISHER ASSOCIATES
P.E., L.S., L.A., D.P.C.

NEW YORK STATE ENGINEER'S SEAL
JAMES J. FISHER
No. 13857
EXPIRATION DATE 12/31/2024

FA PROJECT NO.
210351
PROJECT MANAGER
L. OLIVER
DRAWN BY
C. HARVEY
SCALE
AS SHOWN
ISSUE DATE
05/30/25


PROJECT
ALLE-CATT WIND FARM
ALLE-CATT WIND ENERGY LLC
ALLEGANY, CATTARAUGUS, AND
WYOMING COUNTIES, NEW YORK

TITLE OF DRAWING
ACCESS ROAD T-14 PLAN AND PROFILE



DRAWING NO.
C-205

SHEET 070 OF 248


FILE NAME: H:\Projects\21\210351-00-Alle-Catt-WF\Eng\CAD\GUT\210315_CUT_C-257-C-263.dwg
DATE/TIME: 5/29/2025 5:00:34 PM
USER: Colin Harvey

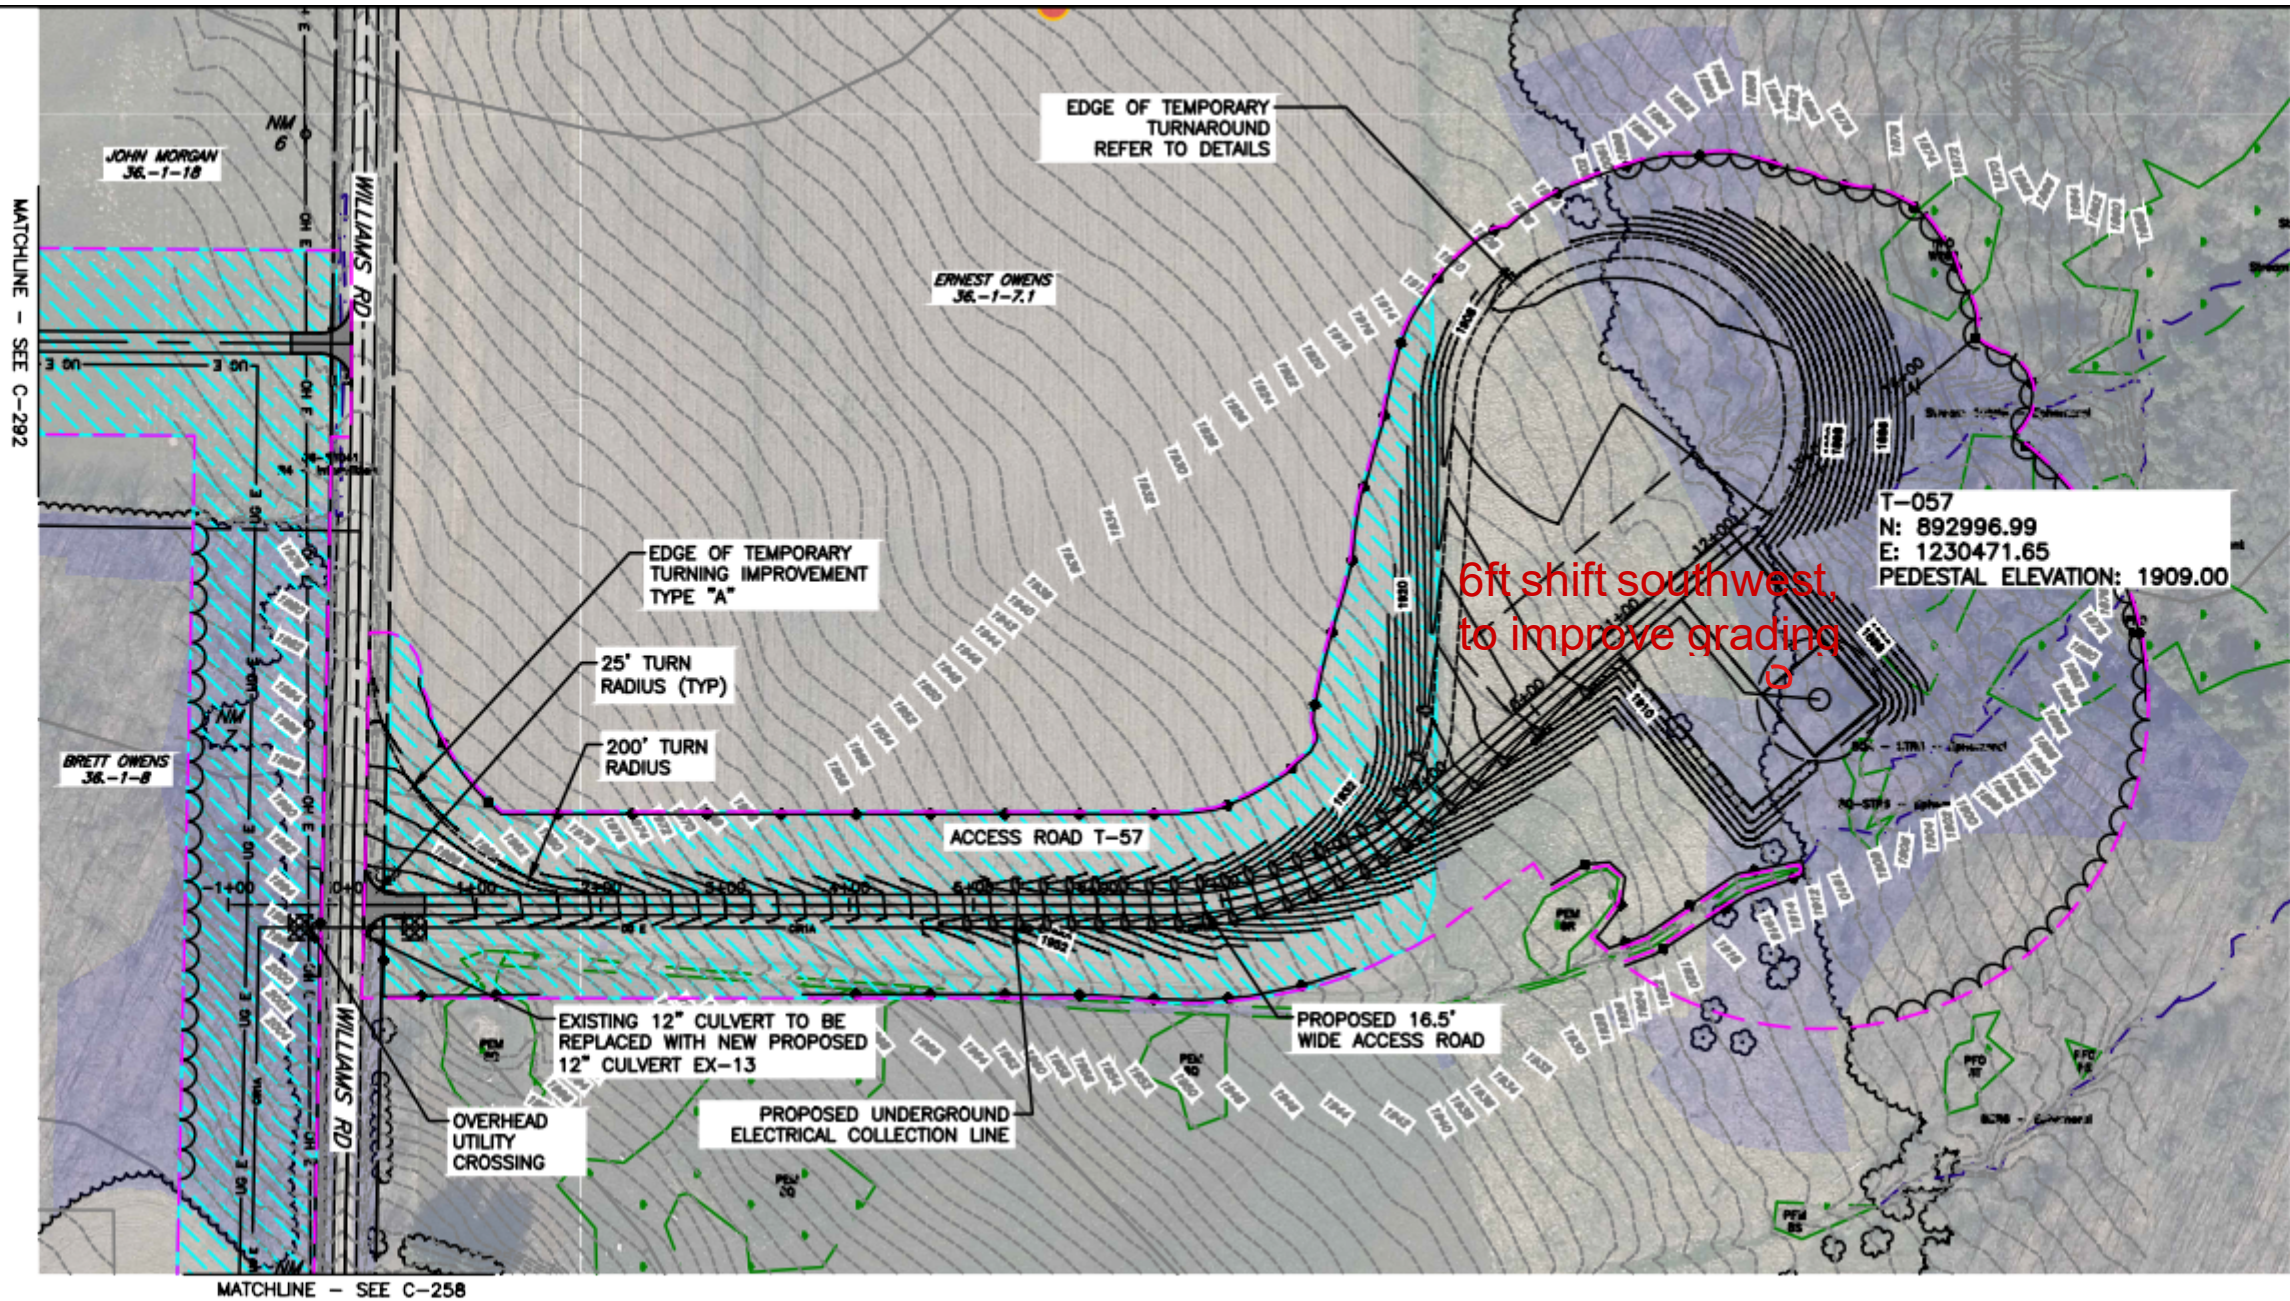

PLAN VIEW
SCALE: 11X17 1"=200'
22X34 1"=100'

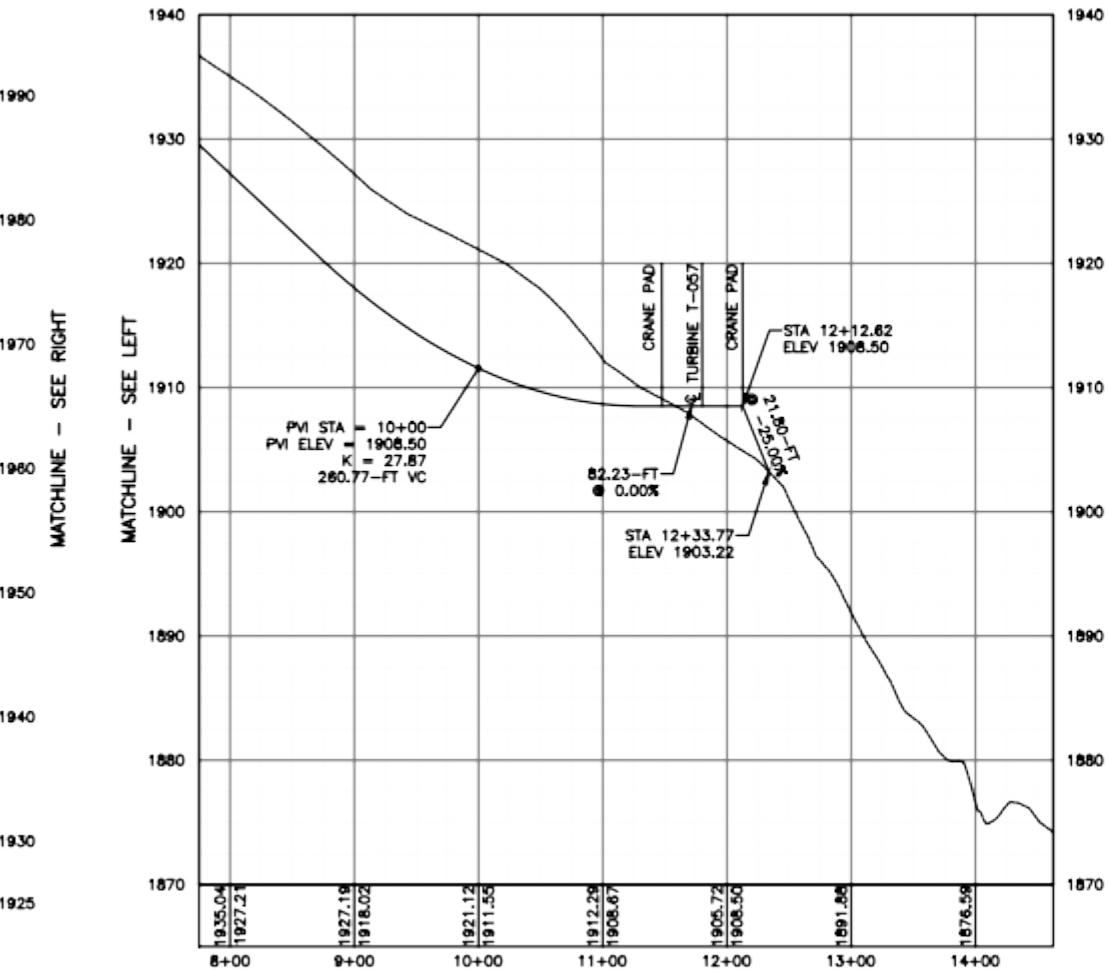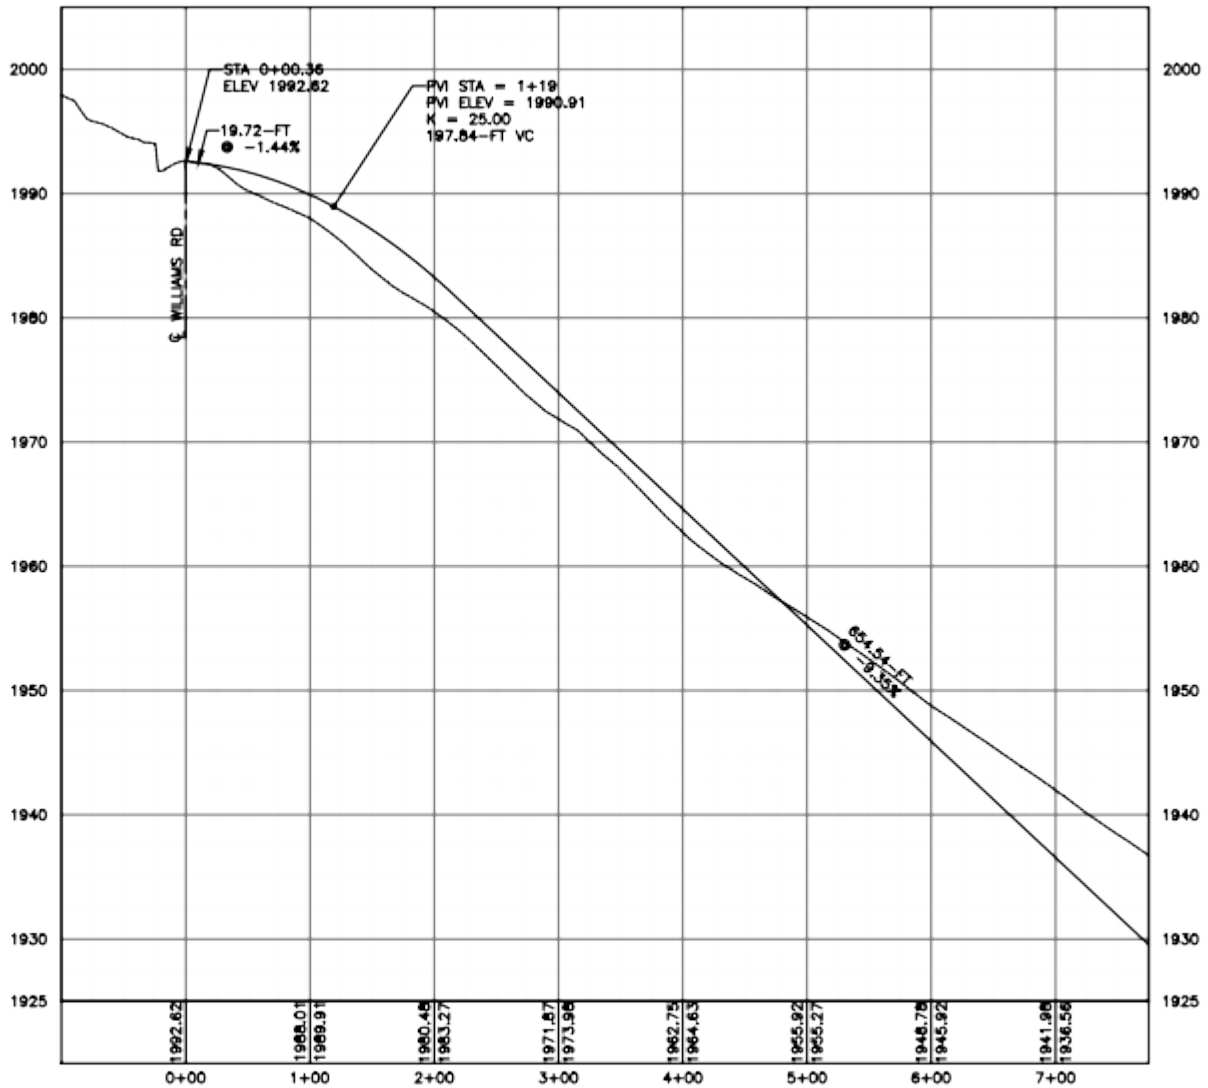

ACCESS ROAD "T-57" PROFILE VIEW
SCALE: HORIZ: 1"=100', VERT: 1"=10'
(24X36" SHEET)

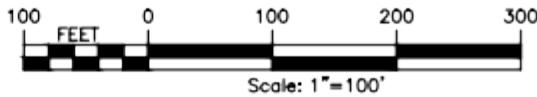


PROJECT		DRAWING NO.	
ALLE-CATT WIND FARM ALLE-CATT WIND ENERGY LLC ALLEGANY, CATTARAUGUS, AND WYOMING COUNTIES, NEW YORK		C-257	
TITLE OF DRAWING		SHEET 122 OF 248	
ACCESS ROAD T-57 PLAN AND PROFILE			
INVENERGY		FISHER ASSOCIATES	
FAPROJECT NO. 210351		PROJECT MANAGER L. OLIVER	
DRAWN BY C. HARVEY		SCALE AS SHOWN	
ISSUE DATE 05/30/25			
DESCRIPTION		REV	
DATE		BY	
		1	
		2	
		3	
		4	
		5	
		6	
		7	



COPYRIGHT © 2021
FISHER ASSOCIATES
P.E., U.S. L.A., D.P.C.

This drawing is the property of Fisher Associates, P.E., U.S. L.A., D.P.C. and shall remain the property of Fisher Associates, P.E., U.S. L.A., D.P.C. It is to be used only for the project and location specified herein. It is not to be reproduced, copied, or used for any other project without the written consent of Fisher Associates, P.E., U.S. L.A., D.P.C.


FILE NAME: H:\Projects\21\210351-00-Alle-Catt-WF\Eng\CAD\GUT\210315_CUT_C-257-C-263.dwg
DATE/TIME: 5/29/2025 5:00:34 PM
USER: Colin Harvey

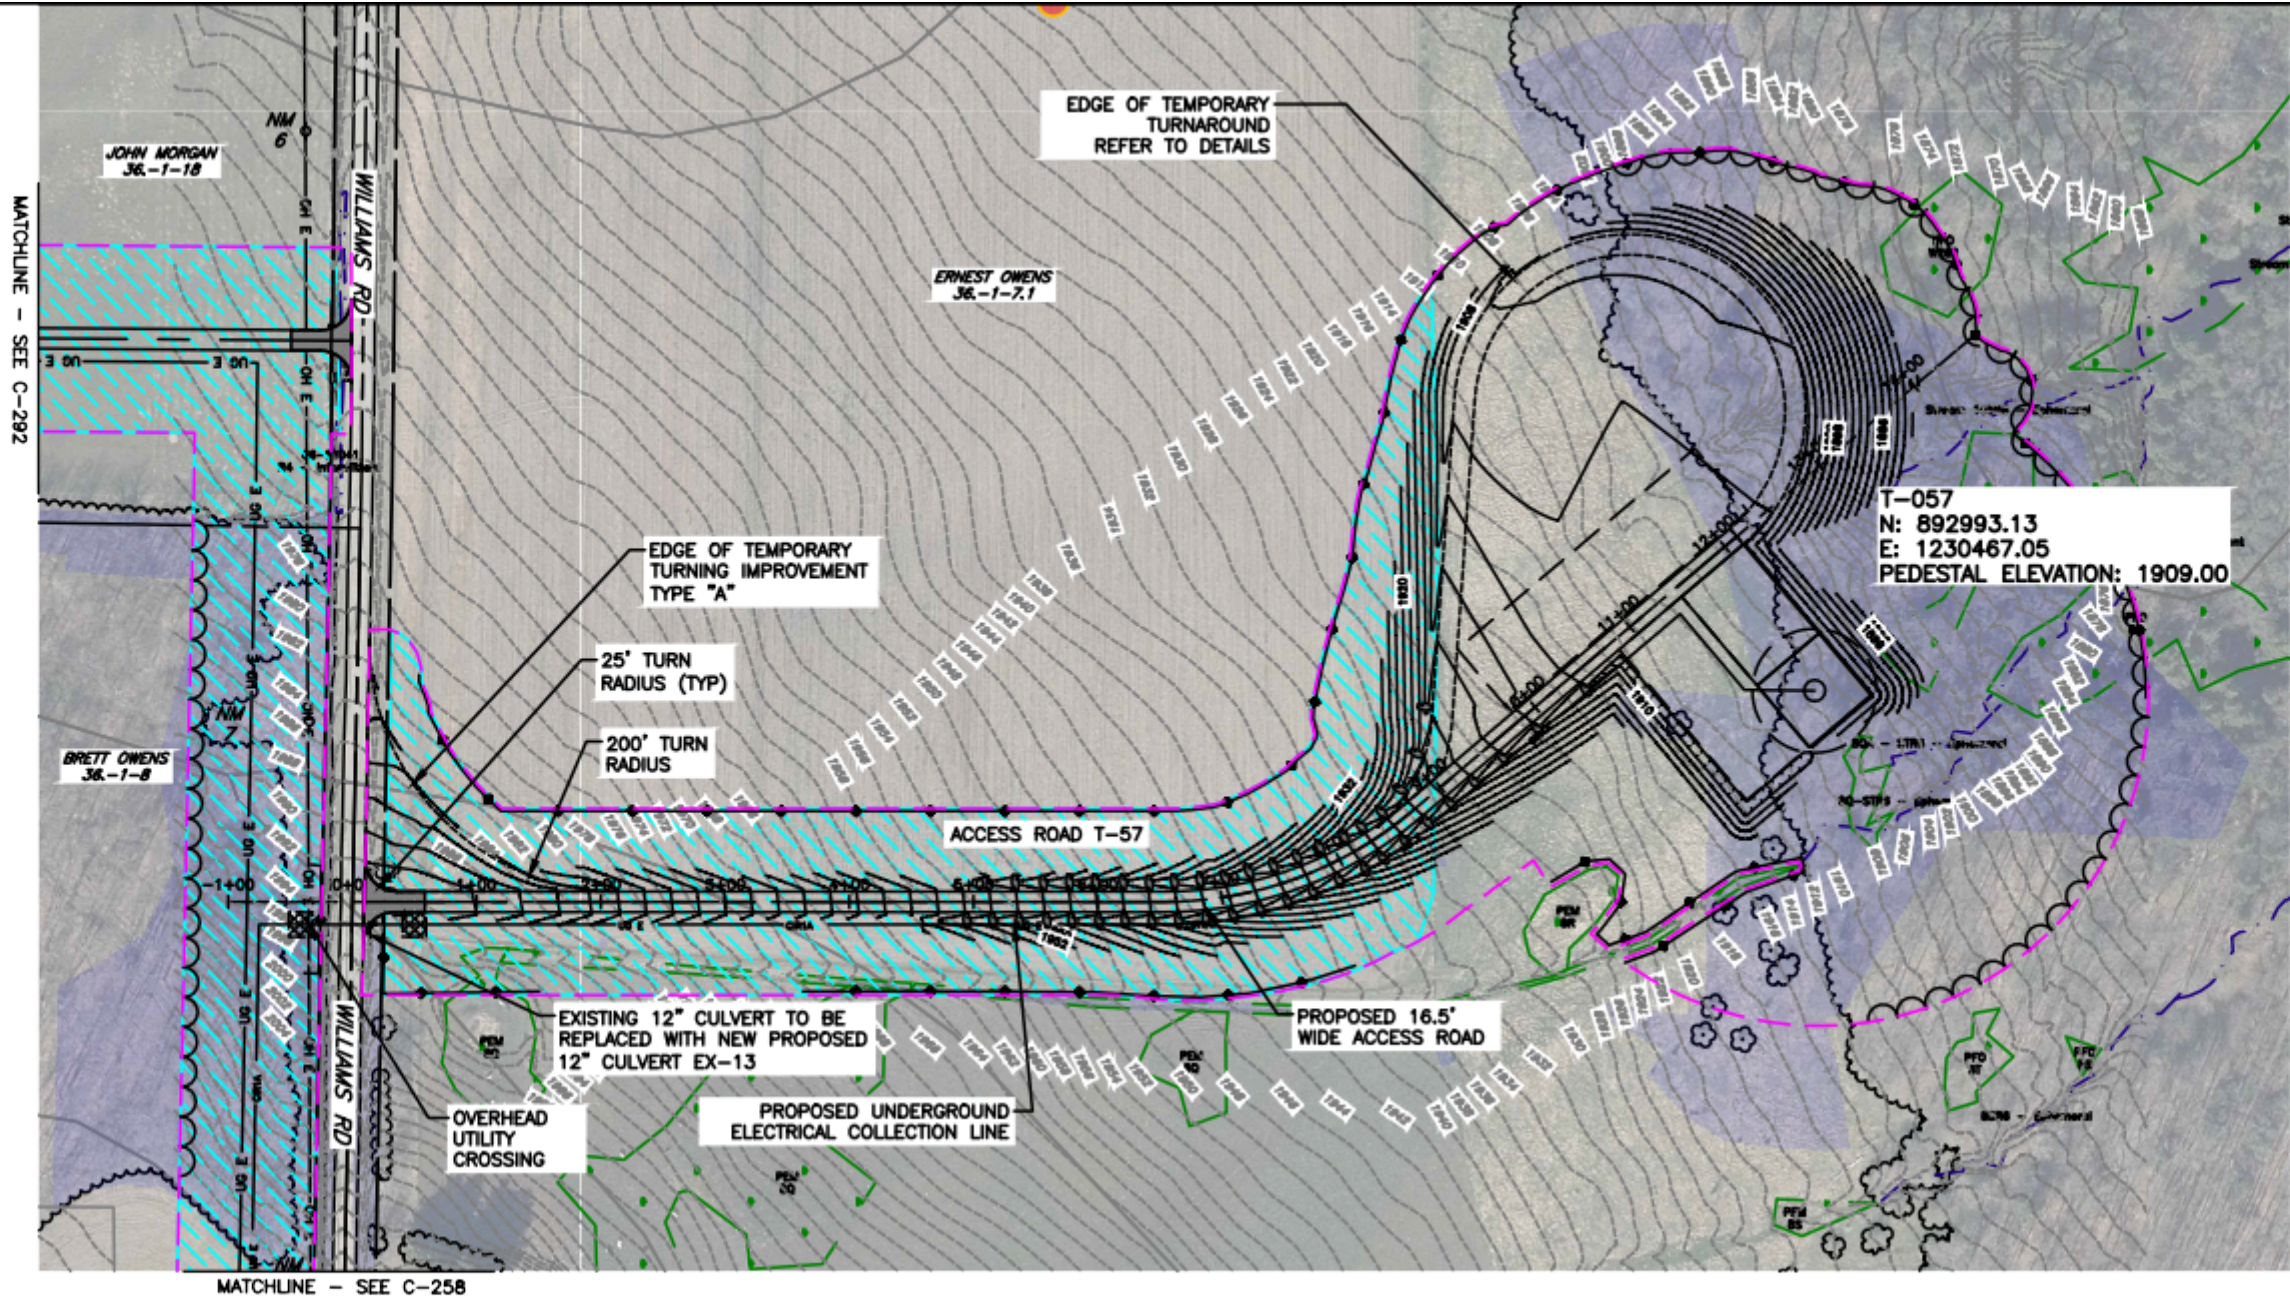


PLAN VIEW
SCALE: 11X17 1"=200'
22X34 1"=100'

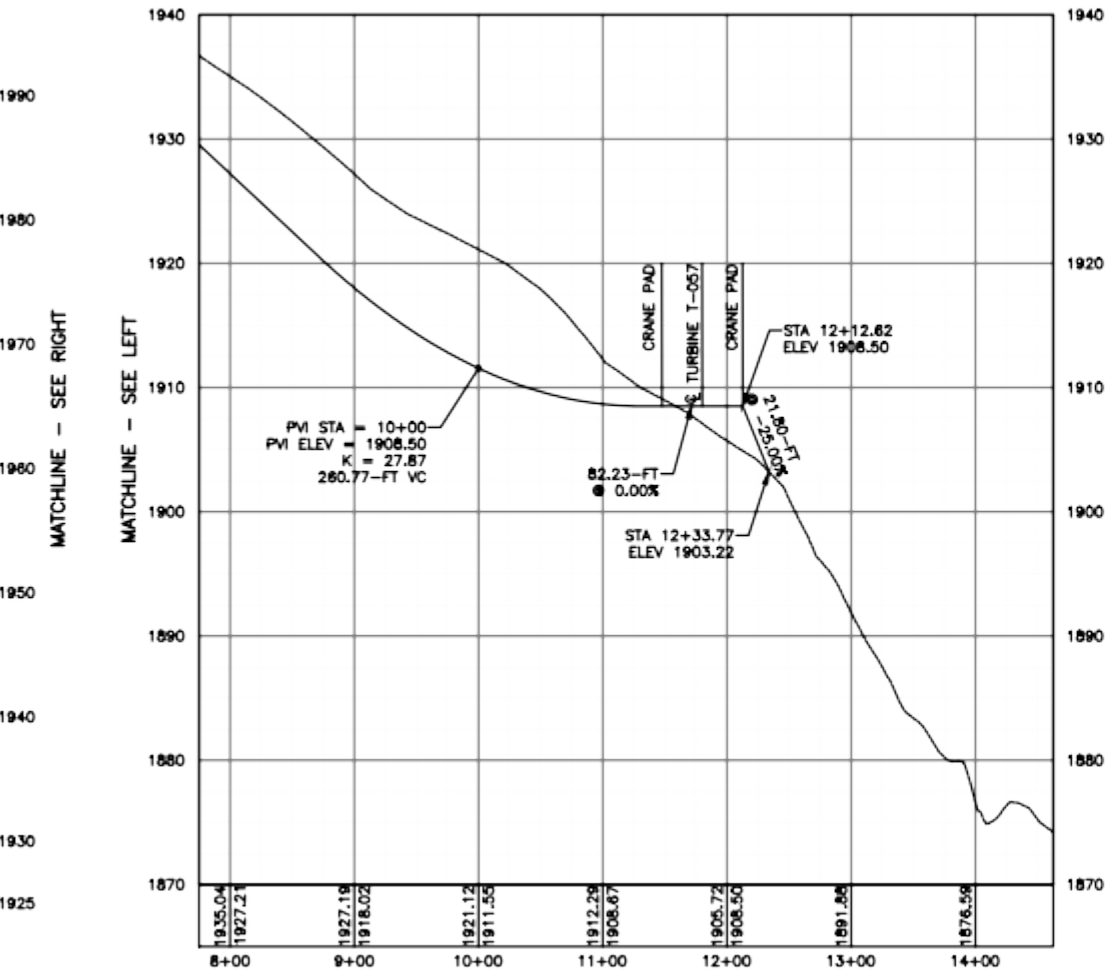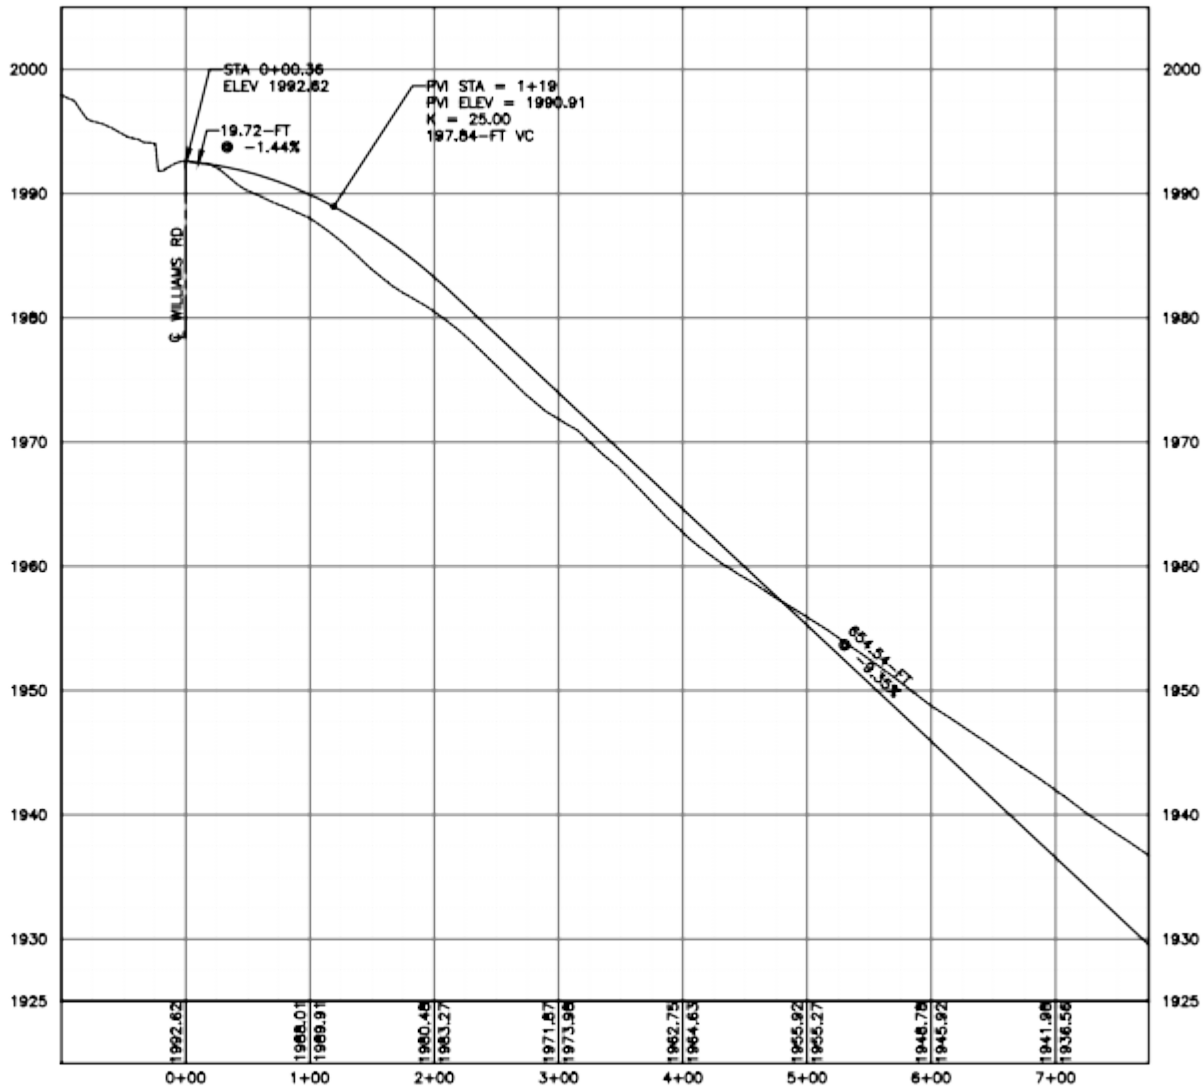


ACCESS ROAD "T-57" PROFILE VIEW
SCALE: HORIZ: 1"=100', VERT: 1"=10'
(24X36" SHEET)

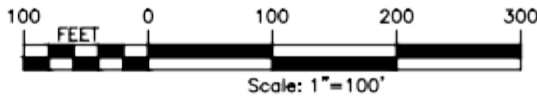

DRAWING NO.		C-257	
PROJECT		ALLE-CATT WIND FARM ALLE-CATT WIND ENERGY LLC ALLEGANY, CATTARAUGUS, AND WYOMING COUNTIES, NEW YORK	
TITLE OF DRAWING		ACCESS ROAD T-57 PLAN AND PROFILE	
FAPROJECT NO.		210351	ISSUE DATE
PROJECT MANAGER		L. OLIVER	05/30/25
DRAWN BY		C. HARVEY	SCALE
		AS SHOWN	
COPYRIGHT © 2021 FISHER ASSOCIATES P.E., U.S. L.A., D.P.C.		REV	DESCRIPTION
7			
6			
5			
4			
3			
2			
1			
		DATE	BY

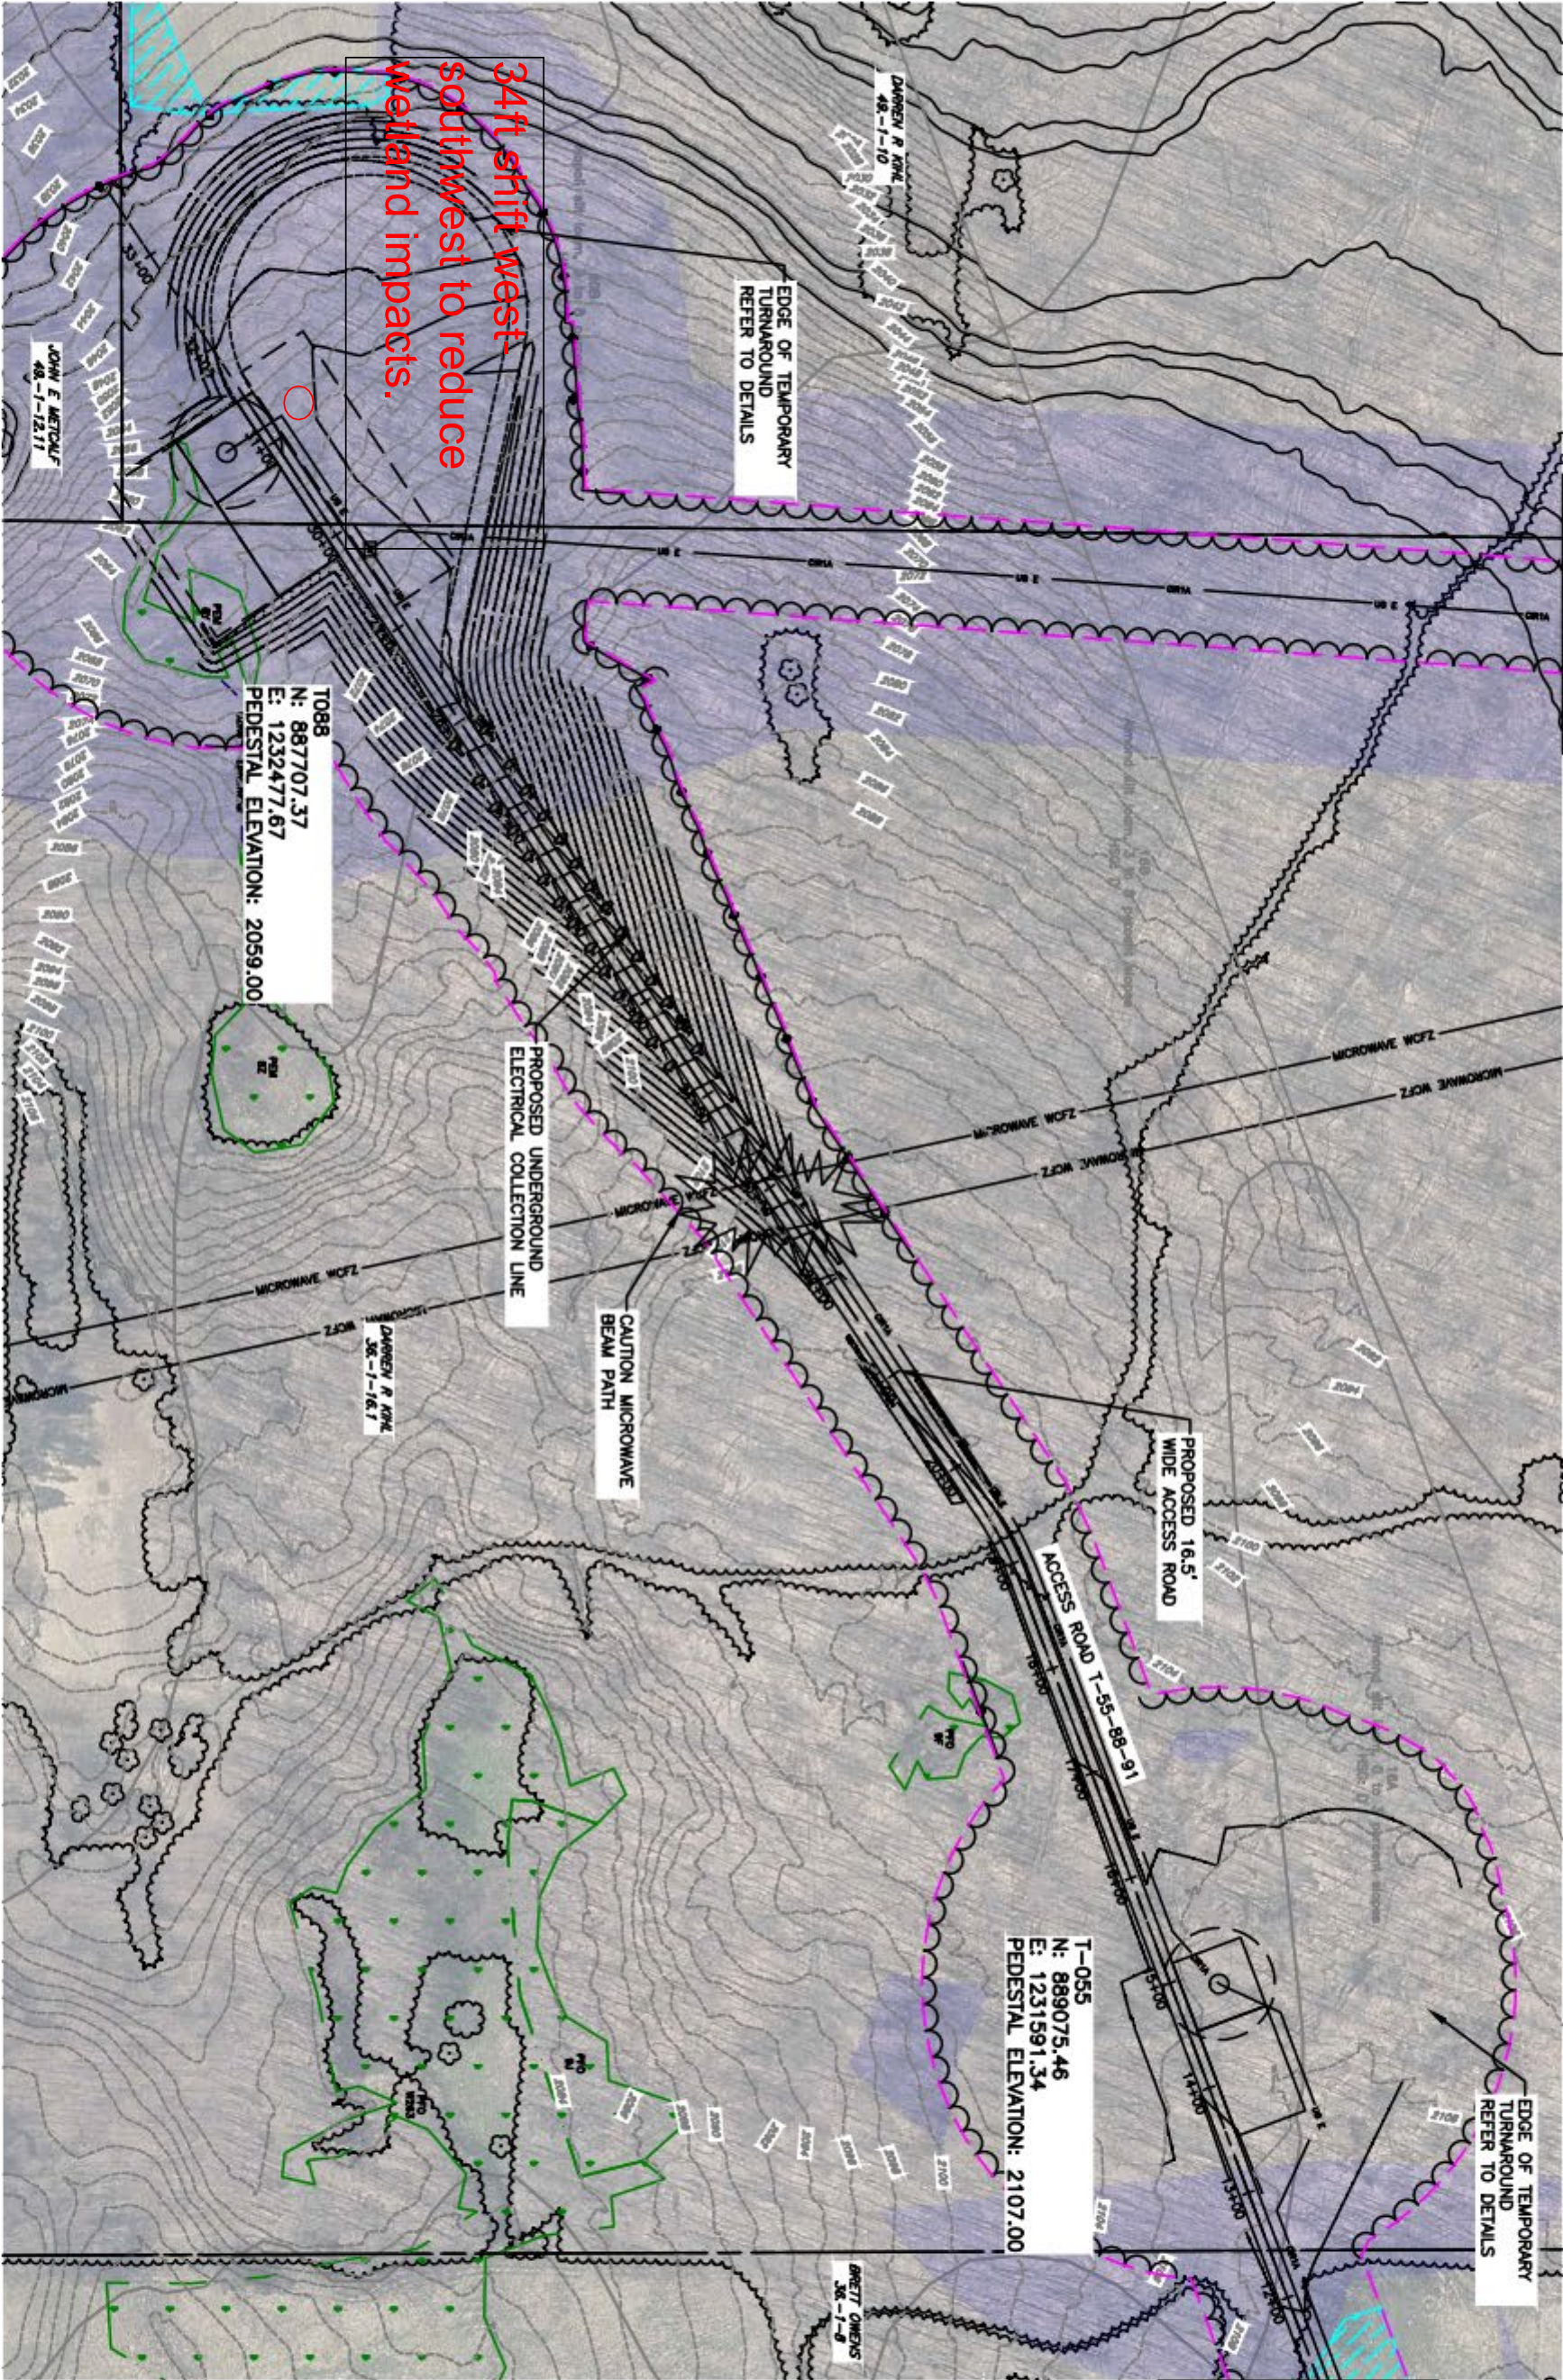

PLAN VIEW
SCALE: 11x17 1"=200'
22x34 1"=100'

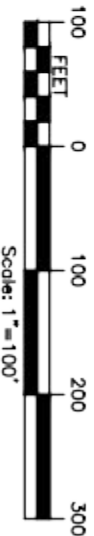

C-259A
SHEET 124 OF 248

PROJECT
ALLE-CATT WIND FARM
ALLE-CATT WIND ENERGY LLC
ALLEGANY, CATTARAUGUS, AND
WYOMING COUNTIES, NEW YORK

TITLE OF DRAWING
ACCESS ROAD T-55-88-91 PLAN


Invenergy



FA PROJECT NO.
210351
PROJECT MANAGER
L. OLIVER
DRAWN BY
C. HARVEY
SCALE
AS SHOWN
ISSUE DATE
05/30/25

COPYRIGHT © 2021
FISHER ASSOCIATES,
P.E., L.S., L.A., D.P.C.
New York State Education Law Section
7220 states that it is a violation of
this law for any person, unless he/she
is acting under the direction of a
licensed professional engineer or land
surveyor, to alter or tamper in any way.
If an item bearing the seal of an
engineer or land surveyor is altered,
the altering engineer or land surveyor
shall affix to the item his/her seal and
the notation "altered by" followed by
his/her signature and the date of such
alteration, and a specific description
of the alteration.

7				
6				
5				
4				
3				
2				
1				
REV	DESCRIPTION	DATE	BY	

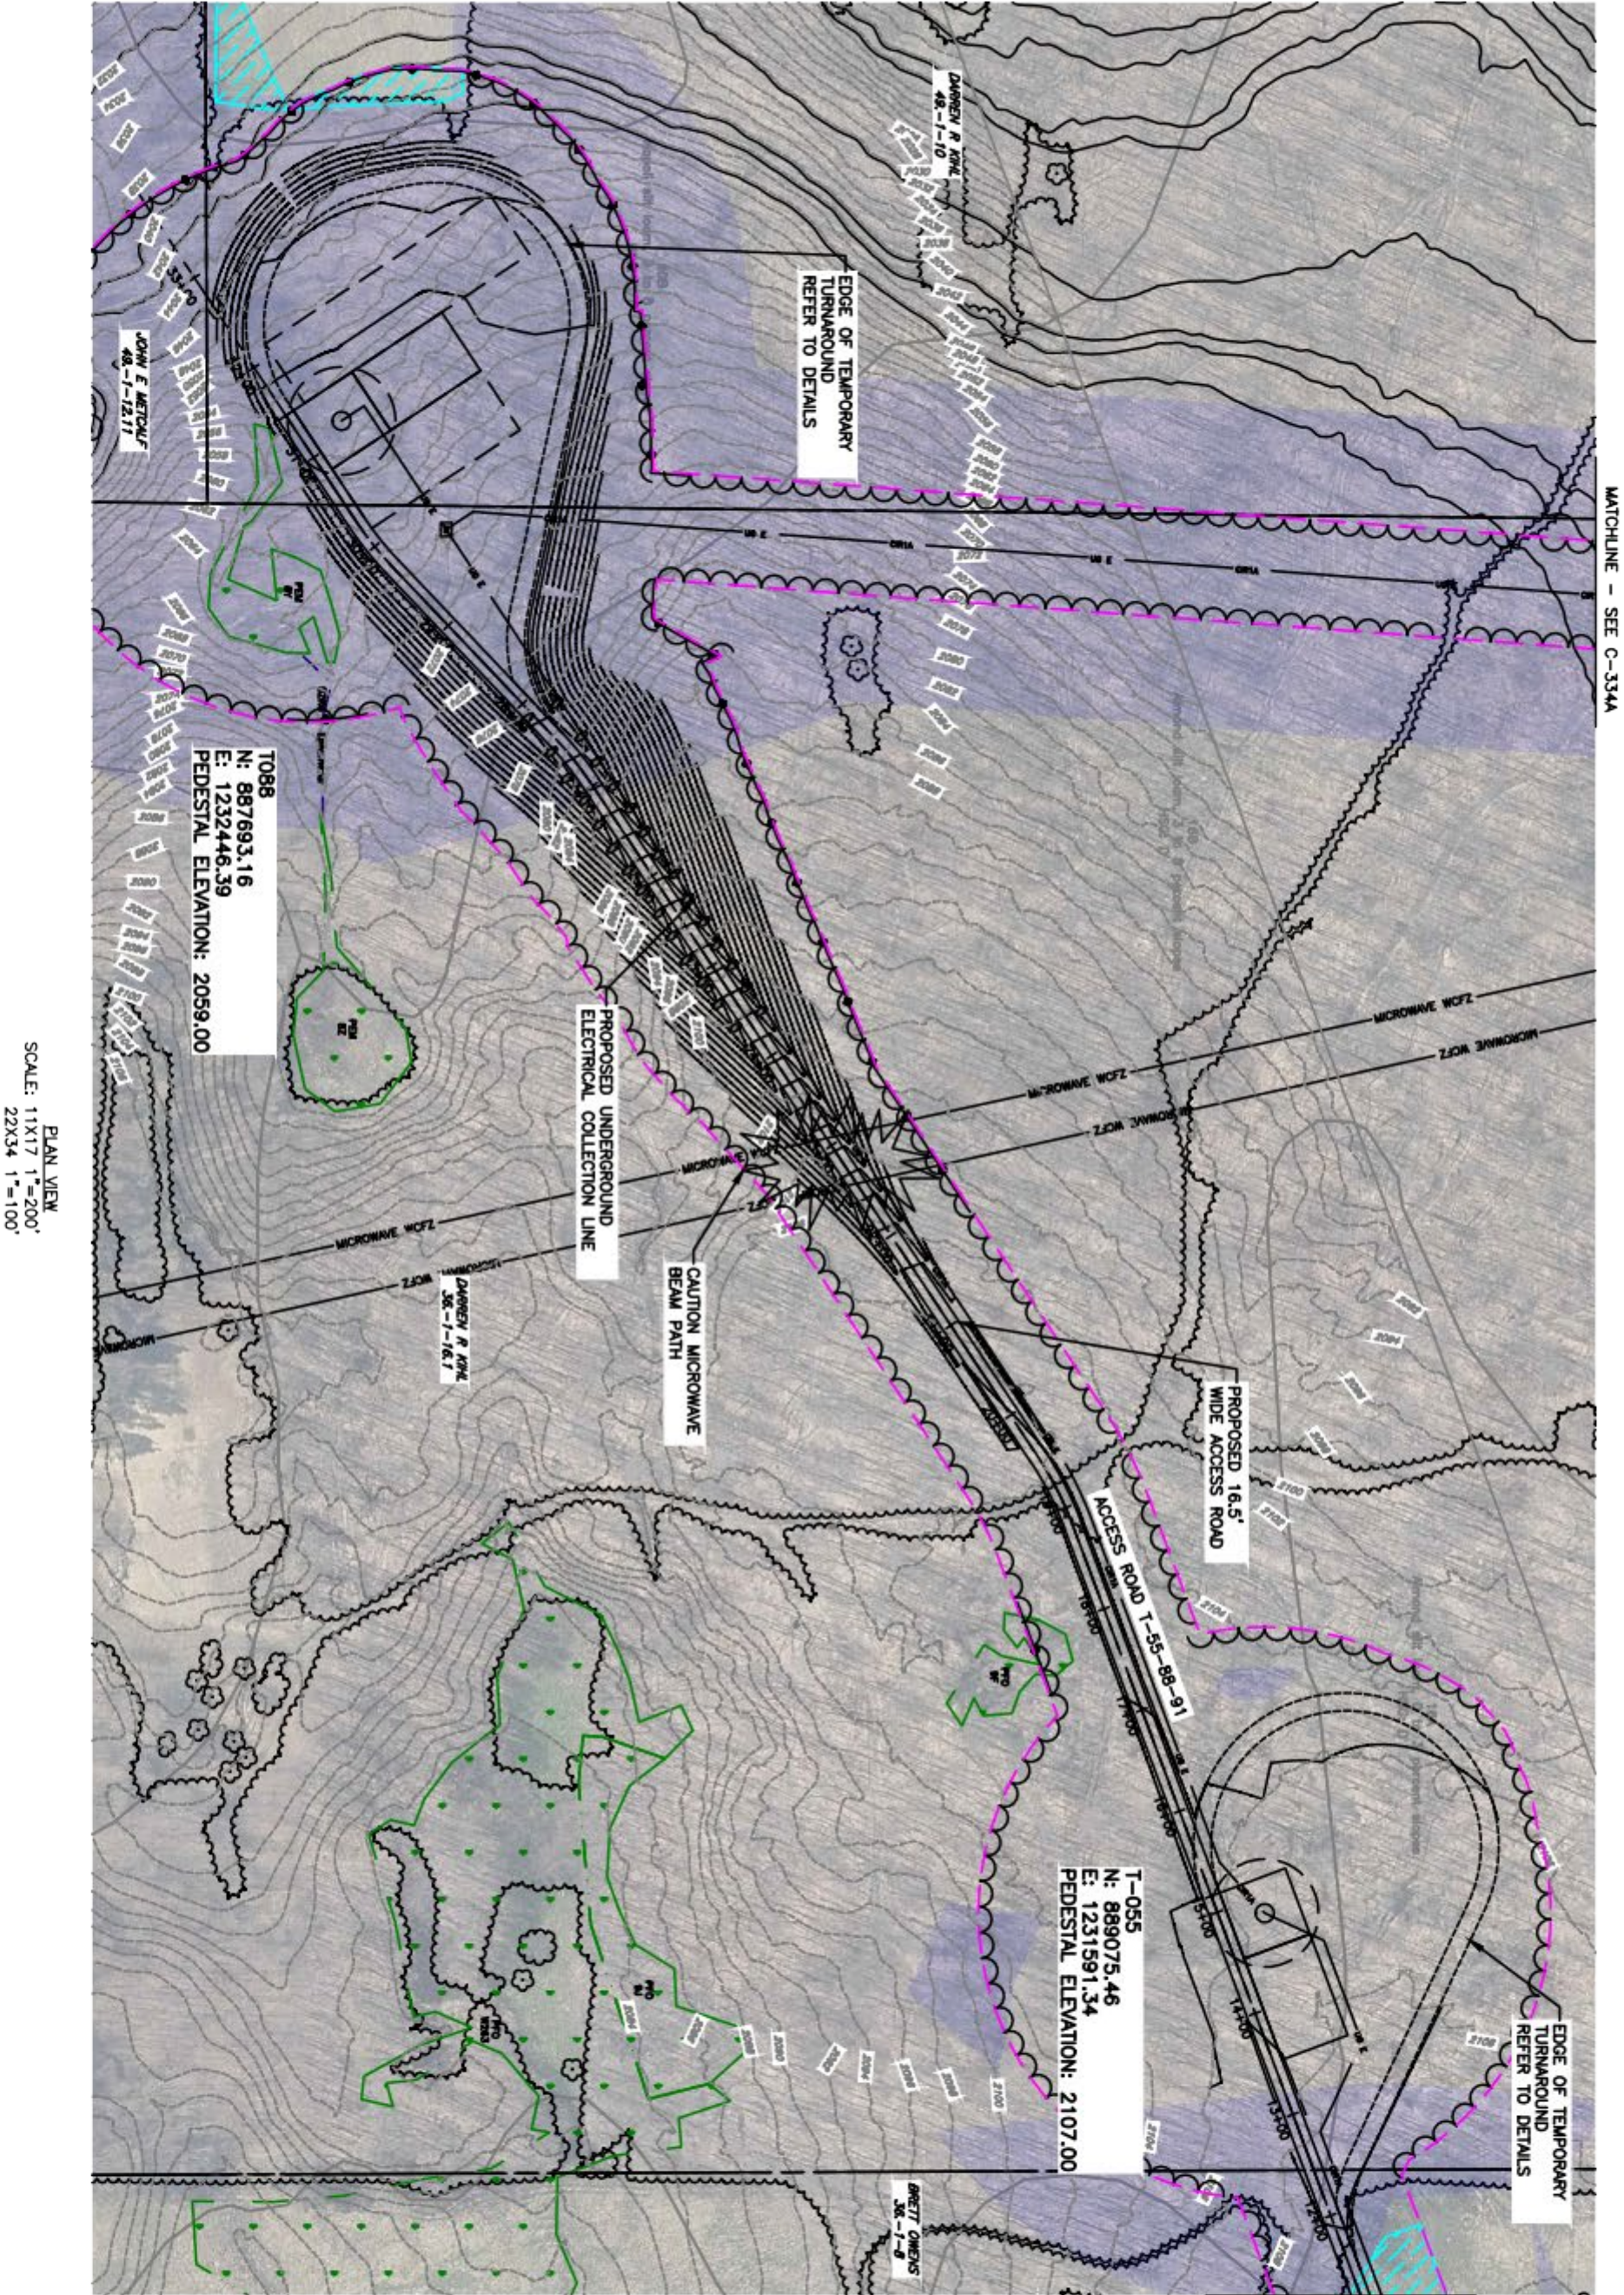

Scale: 1"=100'

PROJECT
ALLE-CATT WIND FARM
ALLE-CATT WIND ENERGY LLC
ALLEGANY, CATTARAUGUS, AND
WYOMING COUNTIES, NEW YORK

TITLE OF DRAWING
ACCESS ROAD T-55-88-91 PLAN

Invenergy



FA PROJECT NO.
210351
PROJECT MANAGER
L. OLIVER

DRAWN BY
C. HARVEY
SCALE
AS SHOWN

ISSUE DATE
05/30/25

COPYRIGHT © 2021
FISHER ASSOCIATES,
P.E., L.S., L.A., D.P.C.

New York State Education Law Section 7220 states that it is a violation of this law for any person, unless he/she is acting under the direction of a licensed professional engineer or land surveyor, to alter or tamper in any way.

If on item bearing the seal of an engineer or land surveyor is altered, the altering engineer or land surveyor shall affix to the item his/her seal and the notation "altered by" followed by his/her signature and the date of such alteration, and a specific description of the alteration.

7				
6				
5				
4				
3				
2				
1				
REV	DESCRIPTION	DATE	BY	