
TREE CLEARING PLANS AND LAYDOWN YARD PLANS

WHITE CREEK SOLAR

135 MW AC (PV) FACILITY

TOWNS OF YORK & LEICESTER, LIVINGSTON COUNTY, NY

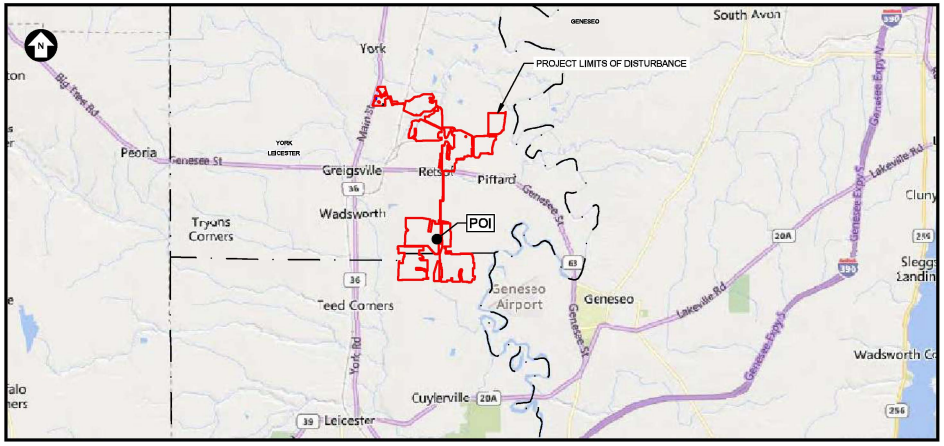

VICINITY MAP
1" = 1 MILE

SHEET LIST	
SHEET NO	SHEET TITLE
TCP-01	COVER SHEET
TCP-02	NOTES, LEGEND & DETAILS
TCP-03	EXISTING CONDITIONS & TREE CLEARING PLAN (1)
TCP-04	EXISTING CONDITIONS & TREE CLEARING PLAN (2)
TCP-05	EXISTING CONDITIONS & TREE CLEARING PLAN (3)
TCP-06	EXISTING CONDITIONS & TREE CLEARING PLAN (4)
TCP-07	EXISTING CONDITIONS & TREE CLEARING PLAN (5)
TCP-08	EXISTING CONDITIONS & TREE CLEARING PLAN (6)
TCP-09	EXISTING CONDITIONS & TREE CLEARING PLAN (7)
TCP-10	EROSION AND SEDIMENT CONTROL DETAILS
TCP-11	EROSION AND SEDIMENT CONTROL DETAILS
TCP-12	EROSION AND SEDIMENT CONTROL DETAILS
TCP-13	EROSION AND SEDIMENT CONTROL DETAILS
TCP-14	EROSION AND SEDIMENT CONTROL DETAILS
TCP-15	SEDIMENT BASIN DETAILS

A PROFESSIONAL ENGINEER HAS REVIEWED THE FACILITY DETAILS AND ATTESTS TO THE ACCURACY OF THE FINAL DESIGN AS REFLECTED IN THE PLANS, PROFILES, ENVIRONMENTAL CONTROLS, AND CONSTRUCTION DETAILS IN ACCORDANCE WITH 16 NYCRR 1100-10.2(e)(1).

Call 811 Before You Dig

Warning/Disclaimer for Issue for Construction (IFC) drawings

It is not possible to identify every hazard in the vicinity of the work depicted on this drawing. Additionally, field conditions could change significantly between the date of this drawing and the date of construction or other field work. Before starting work, all parties performing field work are responsible for verifying actual field conditions and identifying potentially hazardous conditions and circumstances including overhead power lines and subsurface utilities. All parties performing field work are also responsible for complying with all applicable laws and regulations, including safety requirements and mark-outs, pertaining to the work.

aes
2180 South 1300 East, Suite 600
Salt Lake City, UT 84106-2749
(801) 679 - 3500


TRC
249 Western Avenue
Augusta, ME 04330

PE STAMP:



UNDER NEW YORK STATE EDUCATION LAW ARTICLE 145 (ENGINEERING), SECTION 7209 SUBDIVISION 2, IT IS A VIOLATION OF THE LAW FOR ANY PERSON, UNLESS ACTING UNDER THE DIRECTION OF A LICENSED PROFESSIONAL ENGINEER, TO ALTER THIS DOCUMENT.

KEY PLAN:

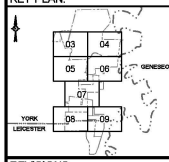

REVISIONS:

	DATE	DESCRIPTION
E	04/08/2026	ISSUED FOR REVIEW
F	04/18/2026	ISSUED FOR REVIEW
G	04/29/2026	ISSUED FOR REVIEW
H	09/11/2026	ADDED LAYDOWN YARD
I	09/18/2026	ADDED SEDIMENT PONDS
J	09/21/2026	REVISED PER CLIENT COMMENTS
K	10/05/2026	ADDED REVISION CLOUDS
L	10/22/2026	ADDED OCSF AROUND ESAs

PROJECT TITLE:

WHITE CREEK SOLAR

PROJECT LOCATION:

TOWN OF YORK &
TOWN OF LEICESTER
LIVINGSTON COUNTY
NEW YORK

SHEET TITLE & DESCRIPTION:

COVER SHEET

ISSUED FOR CONSTRUCTION

PROJ. NUM:	666563
DES:	TRC
DWN:	TRC
CHK:	SGL
APV:	-
DATE:	09/08/2025

SCALE AT 22" x 34":
0 0.5 MI 1 MI 2 MI 3 MI
1" = 1 MILE

SHEET NO: TCP-01
REV: L

AES Titleblock 22X34 v210319

TREE FELLING NOTES:

1. TREES WILL NOT BE FELLED INTO ENVIRONMENTALLY SENSITIVE AREAS, WETLANDS, OR STREAMS. THE DIRECTION IN WHICH TREES AREA TO BE FELLED WILL TAKE INTO CONSIDERATION THE MANAGEMENT OF THE FELLED TREES AND HEALTH AND HUMAN SAFETY. TREES WILL BE CUT AS CLOSE TO THE GROUND AS PRACTICABLE, CONSIDERING SITE CONDITIONS AND THE CONSTRAINTS OF THE EQUIPMENT BEING USED.
2. TREE FELLING ACTIVITIES TO ONLY BE PERFORMED DURING THE ANNUAL BAT HIBERNATION SEASON OF NOVEMBER 1 THRU MARCH 31. THE FOLLOWING FELLING RESTRICTIONS SHALL BE ADHERED TO AT ALL TIME:
   - 2.A. APRIL 1 TO OCTOBER 31: LEAVE UNCUT ALL SNAG AND CAVITY TREES UNLESS IDENTIFIED AS A HAZARD TREE.
   - 2.B. NOVEMBER 1 TO MARCH 31:
     - 2.B.1. ALL TREE FELLING ACTIVITIES, EXCEPT FOR HAZARD TREE REMOVAL, OCCURRING WITHIN 1.5 MILES OF A NORTHERN LONG-EARED BAT (NLEB) MATERNITY ROOST SITE OR (5) MILES OF A HIBERNACULUM SITE.
     - 2.B.2. ALL TREE FELLING ACTIVITIES, EXCEPT FOR HAZARD TREE REMOVAL, OCCURRING WITHIN 2.5 MILES OF AN INDIANA BAT MATERNITY ROOST SITE OR HIBERNACULUM SITE.
   - 2.C. TREE FELLING RESTRICTIONS DO NOT INCLUDE TREES LESS THAN OR EQUAL TO 4" IN DIAMETER AT BREAST HEIGHT. THE ENVIRONMENTAL MONITOR (EM) SHALL BE PRESENT FOR ALL TREE FELLING OPERATIONS AND MAY ISSUE A STOP WORK ORDER IF BAT ACTIVITY IS OBSERVED.
3. TREE FELLING ACTIVITIES WITHIN A WETLAND SHALL CONSIST OF CONTRACTORS ACCESSING THE PROPOSED FELLING AREAS ON UTV'S FOLLOWING EXISTING FARM ACCESS ROADS. ONCE THE AREAS ARE REACHED, THE CONTRACTORS WILL CUT ALL TREES ON FOOT WITH CHAINSAWS & DROP IN-PLACE ("LOPPING AND DROPPING"), WITHOUT THE USE OF ANY CONSTRUCTION EQUIPMENT. TO ELIMINATE ANY POSSIBLE GROUND DISTURBANCES, ALL STUMPS WILL BE LEFT IN-PLACE, WITH NO TREE ROOT REMOVALS. ADDITIONALLY, NO STUMP GRINDING OR CHIPPING WILL OCCUR & NO LOGS/BRANCHES/BRUSH WILL BE MOVED.
4. IF ANY MINOR GROUND DISTURBANCE OCCURS DURING TREE FELLING ACTIVITIES, THE CONTRACTOR SHALL REPAIR THE GROUND DISTURBANCES WITH 4" TOPSOIL, SEED, FERTILIZER, AND STRAW MULCH TO RE-ESTABLISH VEGETATIVE GROUND SURFACES AND TO PREVENT EROSION AND SEDIMENT TRANSPORT.
5. CONSTRUCTION ACTIVITIES SHALL BE PERFORMED IN ACCORDANCE WITH THE STORMWATER POLLUTION PREVENTION PLAN (SWPPP) PREPARED FOR THIS FACILITY.
6. THE CONTRACTOR SHALL BE RESPONSIBLE FOR SUPPLYING ALL MATERIALS, TOOLS, AND EQUIPMENT, INCLUDING SPECIAL CUTTING DEVICES, NECESSARY TO PERFORM THE WORK CONTAINED IN THIS CONTRACT.
7. THE CONTRACTOR SHALL PROTECT ALL EXISTING SITE AMENITIES NOT DESIGNATED FOR REMOVAL.
8. UNLESS OTHERWISE INDICATED ON THE PLANS OR DIRECTED BY THE ENGINEER, THE CONTRACTOR IS RESPONSIBLE FOR PRESERVING AND PROTECTING FROM DAMAGE ALL TREES, SHRUBS AND PLANTS IN THE VICINITY OF THE PROPOSED WORK.
9. ANY KNOWN SITE AMENITY, UTILITY, STREET APPURTENANCE, OR OTHER ITEM WHICH BECOMES DAMAGED AS A RESULT OF THE CONTRACTOR'S OPERATIONS SHALL BE REPAIRED OR REPLACED IN-KIND BY THE CONTRACTOR AS DETERMINED BY THE FACILITY MANAGER OR ENGINEER AND AT NO ADDITIONAL COST TO THE OWNER.
10. THE ARTICLE VIII CERTIFICATE AND ISSUED PERMITS DO NOT ALLOW FOR THE RIGHT TO TRESPASS UPON THE LANDS OR INTERFERE WITH THE PROPERTY AND/OR RIPARIAN RIGHTS OF LANDOWNERS NOT PARTICIPATING IN THE FACILITY.
11. LOCAL FIRE DEPARTMENTS AND EMERGENCY MANAGEMENT TEAMS SHALL BE MADE AWARE OF HAZARDOUS CHEMICALS AND WASTE ON-SITE.
12. REPRESENTATIVES FROM THE US ARMY CORPS OF ENGINEERS, NYS OFFICE OF RENEWABLE ENERGY SITING, NYS DEPARTMENT OF PUBLIC SERVICE AND/OR THE NYS DEPARTMENT OF ENVIRONMENTAL CONSERVATION SHALL BE PERMITTED TO INSPECT THE WORK SITE (INCLUDING RELEVANT RECORDS) AT ANY TIME DEEMED NECESSARY, TO ENSURE THAT ALL ACTIVITIES ARE IN ACCORDANCE WITH THE TERMS AND CONDITIONS SPECIFIED IN THE ISSUED PERMITS AND CERTIFICATES.
13. ANY FINES, PENALTIES OR ENVIRONMENTAL DAMAGE RESULTING FROM ACTIONS PERFORMED BY CONTRACTOR PERSONNEL WORKING ON THIS FACILITY (FROM WORK DIRECTLY OR INDIRECTLY ASSOCIATED WITH THIS FACILITY) SHALL BE THE RESPONSIBILITY OF THE CONTRACTOR.
14. THE CONTRACTOR SHALL NOTIFY EACH LOCAL DEPARTMENT OR AGENCY HAVING JURISDICTION OVER THE ROADWAYS IN THE FACILITY LIMITS OR USED FOR DIRECT ACCESS, OF THE SCHEDULED DATE WHEN WORK WILL BEGIN.
15. FACILITY SITE IS NOT IN A FLOODPLAIN AREA.
16. AVOID ALL DISTURBANCES TO ENVIRONMENTALLY SENSITIVE AREAS (ESA).
17. WINTER STABILIZATION REQUIREMENTS: THE FOLLOWING REQUIREMENTS FOR WINTER
   - 17.A. STABILIZATION APPLY FROM NOVEMBER 15 TO APRIL 1. A. INITIATION OF SOIL STABILIZATION MEASURES TO AREAS WHERE SOIL DISTURBANCE HAS TEMPORARILY OR PERMANENTLY CEASED SHALL BE STARTED BY THE END OF THE NEXT BUSINESS DAY AND COMPLETED WITHIN (3) DAYS.
   - 17.B. STRAW MULCH SHALL BE APPLIED AT DOUBLE THE STARTED RATE (2 TONS PER ACRE).
18. THE FIRST PHASE OF SITE CLEARING SHALL BE PERFORMED USING MECHANIZED EQUIPMENT AND SHALL INCLUDE THE FELLING AND ORGANIZATION OF ALL TREES, BRUSH, AND SLASH MATERIALS WITHIN THE DESIGNATED CLEARING LIMITS. ALL TREES SHALL BE CUT AND PLACED IN AN ORDERLY MANNER WITHIN CLEARING BOUNDARY TO FACILITATE SUBSEQUENT PROCESSING. FELLED TREES AND ASSOCIATED VEGETATION SHALL REMAIN IN PLACE UNTIL FULL NOTICE TO PROCEED (NTP) IS ISSUED FOR SUBSEQUENT CONSTRUCTION ACTIVITIES, AT WHICH TIME THE MATERIAL SHALL BE PROCESSED, REMOVED, OR OTHERWISE DISPOSED OF IN ACCORDANCE WITH PROJECT ENVIRONMENTAL AND CONSTRUCTION SPECIFICATIONS. ALL CLEARING OPERATIONS SHALL BE CONDUCTED IN A CONTROLLED MANNER TO MINIMIZE DISTURBANCE BEYOND THE APPROVED LIMITS OF WORK AND TO MAINTAIN SITE SAFETY AND ENVIRONMENTAL COMPLIANCE AT ALL TIMES.
19. LOW IMPACT VEHICLES ONLY IN ACTIVE AGRICULTURAL AREAS. IF EXCESSIVE RUTTING OR SOIL COMPACTION IS OBSERVED, TEMPORARY TIMBER MATTING SHALL BE UTILIZED.
20. LOCATIONS OF LOG STOCKPILE AREAS MAY BE MODIFIED BASED ON FIELD CONDITIONS IN COORDINATION WITH EM.
21. ONE LOCALIZED FIELD ADJUSTMENT TO THE LOD NEAR THE RIVER ROAD ENTRANCE IS SHOWN APPROXIMATELY PENDING SURVEY CONFIRMATION. ALL OTHER LOD SHOWN HEREIN REFLECTS THE CURRENT PERMITTED TREE CLEARING LIMITS.

CLEARING METHODS

1. TYPE I - CLEARING CONSISTS OF CLEARING THE DESIGNATED AREAS OF ALL WOOD PLANTS, INCLUDING DESIRABLE LOW-GROWING SPECIES. ALL PLANTS WILL BE CUT AS CLOSE TO THE GROUND AS PRACTICABLE, AND AFTER CUTTING NO PLANT WILL EXCEED SIX (6) INCHES ABOVE GROUND LINE. TYPE I CLEARING WILL BE UTILIZED IN CIRCUMSTANCES WHERE WOODY PLANTS WOULD HINDER ACCESS AND CONSTRUCTION ACTIVITIES (I.E., IN CONNECTION WITH CLEARING ACCESS ROADS, WORK AREAS, AND COLLECTION LINE ROUTES.)
2. TYPE II - CLEARING CONSISTS OF CLEARING THE DESIGNATED AREAS OF ANY WOODY PLANTS SPECIES WHICH HAVE THE POTENTIAL TO VIOLATE MINIMUM CLEARANCE DISTANCE. ALL GROWTH WILL BE CUT AS CLOSE TO THE GROUND AS PRACTICABLE, BUT IN NO CASE WILL AFTER-CUTTING HEIGHT EXCEED SIX (6) INCHES ABOVE GROUND LINE, UNLESS OTHERWISE DIRECTED BY THE ENVIRONMENTAL MONITOR (EM).
3. REASONABLE CARE WILL BE TAKEN, INSOFAR AS IS PRACTICAL, TO RETAIN DESIRABLE SPECIES FOUND WITHIN TYPE II CLEARING ZONES. THE ENVIRONMENTAL MONITOR (EM) WILL MAKE A FIELD DETERMINATION AS TO WHETHER SUCH RETENTION WOULD IMPOSE AN UNREASONABLE BURDEN ON CLEARING OR CONSTRUCTION ACTIVITIES.

WOOD/SLASH DISPOSAL METHODS

1. TYPE A - CONSISTS OF REMOVING ALL WOODY DEBRIS FROM THE PROPERTY.
2. TYPE B - CONSISTS OF THE REMOVAL OF ALL LOGS FROM THE PROPERTY. BRUSH/SLASH SHOULD BE CHIPPED AND SPREAD WITHIN THE LIMITS OF DISTURBANCE.
3. TYPE C - LOGS SHALL BE PLACED IN PILES IN DESIGNATED STORAGE AREAS AS SHOWN. OR AT THE EDGE OF THE LIMITS OF DISTURBANCE, AND/OR BE REMOVED FROM THE PROPERTY. BRUSH/SLASH SHOULD BE CHIPPED AND SPREAD WITHIN THE LIMITS OF DISTURBANCE.
4. TYPE D - CONSISTS OF DROPPING LOPPING TREES SO THAT THE SLASH LIES AS CLOSE TO THE GROUND AS PRACTICABLE, WITH BRANCHES AND LIMB WOOD NOT EXCEEDING AN AVERAGE DEPTH OF TWENTY-FOUR (24) INCHES. INCLUDING WETLAND AND STREAMS AREAS, TYPE D WOOD DISPOSAL WILL ADHERE TO THE FOLLOWING ADDITIONAL CONDITIONS INCLUDED:
   - 4.A. ONLY A SELECTIVE PORTION OF VEGETATION, AS NEEDED TO PREVENT THE BLOCKING OF FLOW AND THE TRAPPING OF DEBRIS, IS TO BE REMOVED FROM THE WATER COURSE AND FLOODWAY, ALL CUTTINGS (REGARDLESS OF LOCATIONS) ARE TO BE CUT AND BUCKED TO LIE NEAR GROUND LEVEL. HOWEVER, WHERE TREE ROOT BASES ARE ATTACHED TO THE STREAM BANK, THEY WILL BE LEFT IN PLACE. THE REMAINDER OF THE TREE WILL BE CUT FROM THE BASE PRIOR TO REMOVAL.

DANGER TREES

1. A DANGER TREE IS ANY TREE ROOTED OUTSIDE OF A RIGHT OF WAY (ROW) THAT, DUE TO ITS PROXIMITY AND PHYSICAL CONDITION (I.E., MORALITY, LEAN, DECAY, CAVITIES, CRACKS, WEAK BRANCHING, ROOT LIFTING, OR OTHER INSTABILITY). POSES A PARTICULAR DANGER TO KEY FACILITY COMPONENTS.
2. ALL DANGER TREES WILL BE REMOVED AT THE TIME OF THE INITIAL CLEARING AND AS PART OF THE NORMAL CLEARING ACTIVITIES. THE SLASH FROM THESE DANGER TREES WILL BE DISPOSED OF IN ACCORDANCE WITH THE SLASH DISPOSAL METHOD DESIGNATED FOR THE WORK AREA ADJOINING THE AREA FROM WHICH THE DANGER TREES HAVE BEEN REMOVED.

PROCEDURE FOR OFF-SITE REMOVAL OF STUMPS, CHIPS, AND SLASH

1. WHERE OFF-SITE REMOVAL OF STUMPS, CHIPS, OR SLASH IS NECESSARY, ALL MATERIALS WILL BECOME THE PROPERTY OF THE CONTRACTOR. IN ALL CASES, ALL MATERIAL THAT IS REMOVED FROM THE SITE WILL BE DISPOSED ON IN AN ENVIRONMENTALLY-ACCEPTABLE MANNER AND IN COMPLIANCE WITH ALL APPLICABLE RULES AND REGULATIONS INCLUDING 6 NYCRR PART 192 AND ALL OTHER INVASIVE SPECIES REGULATIONS.
2. THE CONTRACTOR WILL PROVIDE THE CERTIFICATE HOLDER WITH A DESCRIPTION AND THE LOCATION OF ALL PROPOSED OFF-SITE DISPOSAL SITES PRIOR TO THE START OF THE PROJECT. THE ENVIRONMENTAL MONITOR (EM) WILL INSPECT ALL PROPOSED OFF-SITE DISPOSAL SITES TO ENSURE THAT THEY ARE SUITABLE AND WILL NOTIFY DPS STAFF.

CONSTRUCTION NOTES:

1. ALL DISTURBED AREAS ARE TO BE RESTORED TO PRE-EXISTING OR BETTER CONDITIONS. THE CONTRACTOR IS TO ENSURE RESTORATION OF THE ENTIRE WORK SITE IS IN COMPLIANCE WITH THE ARTICLE VIII SITING PERMIT.
2. CONTRACTOR IS RESPONSIBLE FOR ADHERING TO ALL OSHA SAFETY REGULATIONS DURING CONSTRUCTION.
3. ALL DIMENSIONS SHOWN ON THE PLANS SHALL BE FIELD VERIFIED BY THE CONTRACTOR PRIOR TO CONSTRUCTION. THE CONTRACTOR SHALL NOTIFY WHITE CREEK SOLAR IF ANY DISCREPANCIES EXIST PRIOR TO PROCEEDING WITH CONSTRUCTION.
4. THERE ARE ADDITIONAL NOTES, SPECIFICATIONS AND REQUIREMENTS CONTAINED THROUGHOUT THE PLAN SET AS WELL AS REFERENCES TO SPECIFICATIONS FROM APPLICABLE GOVERNING AUTHORITIES AND INDUSTRY STANDARDS. IT IS THE CONTRACTOR'S RESPONSIBILITY TO OBTAIN, REVIEW AND ADHERE TO ALL THESE DOCUMENTS.
5. ALL ROADWAY, SHOULDER, DRIVEWAY AND FENCE DISTURBANCE SHALL BE REMEDIED AND REPLACED IN KIND, UNLESS OTHERWISE NOTED. ACCESS TO THE CONSTRUCTION SITE SHALL BE FROM APPROVED ACCESS POINTS ONLY.
6. FULL SIZE SHEETS OF THIS PLAN SET SHALL BE PRINTED OUT AT 24"x36". THE CONTRACTOR MUST VERIFY THE SCALE OF THESE DRAWINGS. NO ASSURANCES OF THE ACCURACY OF THE SCALE OF PLANS PRINTED AT OTHER SIZES ARE MADE OR IMPLIED.
7. ANY STRAW USED SHALL BE EITHER WHEAT OR OAT, FREE OF WEEDS, AND NOT CHOPPED OR FINELY BROKEN. HAY IS NOT APPROVED AS A MULCH MATERIAL.
8. AS STATED BELOW IN THE ENVIRONMENTAL PROTECTION SECTION, CONTRACTOR TO HAVE FLAGGING IN PLACE FOR ENVIRONMENTALLY SENSITIVE AREAS (ESAs) PRIOR TO TREE FELLING. FLAGGING FOR ESAs SHALL CONSIST OF COLORED FLAGGING, "PROTECTED AREA" SIGNS, OR EROSION AND SEDIMENT CONTROL MEASURES SPECIFIED BY THE SWPPP. IF NECESSARY TO PREVENT ACCESS BY MOTORIZED VEHICLES INTO ESAs WHERE NO CONSTRUCTION IS PLANNED, THE CONTRACTOR SHALL INSTALL ADDITIONAL MARKERS OR SIGNS STATING, "NO EQUIPMENT ACCESS."
9. NO FUELING OF EQUIPMENT IS TO BE PERFORMED WITHIN ESAs.
10. IF APPLICABLE, THE CONTRACTOR SHALL INSTALL ORANGE CONSTRUCTION FENCE AND "NO ACCESS" SIGNS AT ALL ROAD AND RAILROAD CROSSINGS PRIOR TO CONSTRUCTION AND ADHERE TO ALL PERMIT CONDITIONS FOR WORK IN THOSE AREAS.
11. POST A LAMINATED CONTACT/NOTIFICATION TREE (PM → SUPERINTENDENT → PI/AT → OWNER REP → ORES/SHPO PER UDP) AT THE TRAILER AND FOREMAN'S BOARD; KEEP NUMBERS CURRENT.
12. PROPOSED ACCESS ROUTES MAY BE MODIFIED WITHIN THE LOD BASED ON FIELD CONDITIONS IN COORDINATION WITH THE OWNER AND EM
13. THE CONTRACTOR SHALL MONITOR AND GUARANTEE THAT ALL PLANTS, TREES, AND SHRUBS SHALL BE HEALTHY AND FREE OF DISEASE FOR A PERIOD OF (1) ONE YEAR AFTER SUBSTANTIAL COMPLETION AND ACCEPTANCE BY THE OWNER. CONTRACTOR SHALL REPLACE ANY DEAD OR UNHEALTHY PLANTS AT CONTRACTOR'S EXPENSE. FINAL ACCEPTANCE SHALL BE MADE IF ALL PLANTS MEET THE GUARANTEE REQUIREMENTS INCLUDING MAINTENANCE. MAINTENANCE RESPONSIBILITIES INCLUDE INVASIVE SPECIES MONITORING, REMOVAL, AND SUPPLEMENTATION. MONITORING OF THE PROJECT SITE SHALL OCCUR IN THE SPRING AND THE FALL TO DETERMINE THE PRESENCE OF INVASIVE SPECIES. SHOULD ANY INVASIVE SPECIES BE IDENTIFIED WITHIN THE PROJECT SITE, THE INVASIVE SPECIES SHALL BE REMOVED ACCORDING TO METHODS MOST LIKELY TO BE EFFECTIVE IN CONTROLLING THAT SPECIES AND SUPPLEMENTING ITS REPLACEMENT WITH APPROPRIATE VEGETATION AND SEED MIX IDENTIFIED (AND APPROVED) ON THIS PLAN AND/OR AN APPROVED EQUAL. ADDITIONAL MAINTENANCE RESPONSIBILITIES MAY INCLUDE BUT ARE NOT LIMITED TO: APPROVED CULTIVATING, SPRAYING, WEEDING, WATERING, TIGHTENING OF TREE STRAP GUYS, PRUNING, FERTILIZING, MULCHING, AND ANY OTHER OPERATIONS NECESSARY TO MAINTAIN PLANT VIABILITY. MAINTENANCE SHALL BEGIN IMMEDIATELY AFTER PLANTING AND CONTINUE UNTIL 90 DAYS AFTER FINAL ACCEPTANCE.
14. ALL TEMPORARY PARKING AREAS SHALL BE TIMBER MATTING.

CONSTRUCTION SEQUENCE NOTES:

1. THE GENERAL CONSTRUCTION SEQUENCE BELOW IS A GUIDELINE AND IS INTENDED FOR USE BY THE CONTRACTOR AS A GENERAL COURSE OF ACTION. ALL NECESSARY WORK TO ENSURE PROPER, ACCURATE, AND COMPLETE EXECUTION OF THE FACILITY, WHETHER OR NOT SPECIFICALLY MENTIONED IN THE SEQUENCE BELOW OR SHOWN ON THE FACILITY DRAWINGS IS THE RESPONSIBILITY OF THE CONTRACTOR. IT IS NOT INTENDED THAT THE DRAWINGS SHOW EVERY DETAILED PIECE OF MATERIAL OR EQUIPMENT. THE CONTRACTOR SHALL COMPLY WITH THE REQUIREMENTS LISTED IN THIS SECTION AND ON THE FACILITY DRAWING AT MINIMUM AND SHALL COMPLY WITH THE ARTICLE VIII SITING PERMIT AND WATER QUALITY CERTIFICATE. WHITE CREEK SOLAR SHALL HIRE AN INDEPENDENT, THIRD-PARTY ENVIRONMENTAL MONITOR (EM) TO OVERSEE COMPLIANCE WITH ENVIRONMENTAL COMMITMENTS AND ARTICLE VIII SITING PERMIT REQUIREMENTS. IF THE EM IS NOT QUALIFIED, WHITE CREEK SOLAR SHALL ALSO HIRE AN INDEPENDENT, THIRD-PARTY AGRICULTURAL MONITOR (AM) TO OVERSEE COMPLIANCE WITH AGRICULTURAL CONDITIONS AND ARTICLE VIII REQUIREMENTS.
2. THE EM/AM/SWPPP INSPECTOR SHALL PERFORM REGULAR SITE INSPECTIONS OF CONSTRUCTION WORK SITES AND, IN CONSULTATION WITH ORES, ISSUE REGULAR REPORTING COMPLIANCE AUDITS. THE EM/AM/SWPPP INSPECTOR SHALL INSPECT THE EROSION AND SEDIMENT CONTROL PRACTICES AND POLLUTION PREVENTION MEASURES BEING IMPLEMENTED WITHIN THE WORK AREA THROUGHOUT THE DURATION OF THE FACILITY IN ACCORDANCE WITH THE NYSDEC SPDES GENERAL PERMIT FOR STORMWATER DISCHARGES FROM CONSTRUCTION ACTIVITY, THE ARTICLE VIII SITING PERMIT, AND THE WATER QUALITY CERTIFICATE.
3. CONTRACTOR SHALL COOPERATE WITH THE EM/AM/SWPPP INSPECTOR AT ALL TIMES BY MAINTAINING COMPLIANCE WITH ALL PERMIT CONDITIONS AND PROVIDING TIMELY RESPONSES TO SUGGESTED IMPROVEMENTS.
4. THE CONTRACTOR MAY BE REQUIRED TO ALTER ENVIRONMENTAL CONTROLS SHOWN ON THE FACILITY DRAWINGS BASED ON EFFECTIVENESS OF CONTROLS, THE REQUEST OF THE EM OR DIFFERING CONDITIONS ENCOUNTERED IN THE FIELD AT THE TIME OF CONSTRUCTION. ALL EARTH DISTURBANCE ACTIVITIES SHALL PROCEED IN ACCORDANCE WITH THE GUIDELINE SEQUENCE BELOW. CONSTRUCTION ACTIVITIES WITHIN EACH STAGE OF THE FACILITY MAY OVERLAP PROVIDED THAT WORK WITHIN EACH AREA IS CARRIED OUT IN ACCORDANCE WITH THE SEQUENCE GUIDELINES.
5. AT LEAST (2) WEEKS BEFORE TREE FELLING, THE CONTRACTOR SHALL STAKE OR FLAG THE PLANNED LIMITS OF DISTURBANCE (LOD), THE BOUNDARIES OF ANY DELINEATED WETLANDS, WATERBODIES, OR STREAMS AND ASSOCIATED ADJACENT AREAS IN THE LOD, AND ANY KNOWN ARCHAEOLOGICAL SITES IDENTIFIED IN THE APPROVED CULTURAL RESOURCES AVOIDANCE, MINIMIZATION AND MITIGATION PLAN, LIMITS OF FELLING AND OTHER AREAS NEEDED FOR CONSTRUCTION. IN ADDITION, ALL ESAs SHALL BE MARKED ACCORDING TO REQUIREMENTS IN THE ENVIRONMENTAL PROTECTION SECTION BELOW.
6. LOCATE STAGING AREAS AND ACCESS POINTS INCLUDING CONSTRUCTION ENTRANCES IF NEEDED. INSTALL PERIMETER SEDIMENT BARRIERS DOWN SLOPE OF THESE AREAS, WHERE REQUIRED.
7. MINIMIZE TOTAL AREA OF DISTURBANCE TO THE PERMITTED LIMITS OF DISTURBANCE SHOWN ON THE PLANS. INSTALL PERIMETER SEDIMENTATION CONTROLS AS REQUIRED AT LOCATIONS BELOW AREAS OF DISTURBANCE SHOWN ON THE PLANS AND IN ACCORDANCE WITH THE DETAILS PROVIDED.

SURVEY NOTES:

1. TOPOGRAPHIC SURVEY AND ALTA SURVEY PERFORMED BY THEW ASSOCIATES. EXISTING CONDITION INFORMATION CONTAINED WITHIN THESE DRAWINGS REFLECT THE SURVEY PROVIDED BY THEW ASSOCIATES DATED 10/02/2023.
2. COORDINATE SYSTEM: NAD83 NEW YORK STATE PLANES, WEST ZONE, US FOOT.
3. ENVIRONMENTALLY SENSITIVE AREAS PROVIDED BY EDR.
4. WETLAND AND STREAM BOUNDARIES PROVIDED BY EDR VIA "WETLAND AND STREAM DELINEATION REPORT", DATED JUNE 2023.
5. KARST AREAS PROVIDED BY TERRACON CONSULTANTS VIA "MINE AND KARST SURVEY ASSESSMENT REPORT" DATED AUGUST 2023.

SITE NOTES:

1. ALL STAKEOUT FOR THE PROPOSED SITE IMPROVEMENTS SHALL BE COMPLETED BY A NEW YORK STATE LICENSED LAND SURVEYOR.
2. IF ANY DISCREPANCIES ARE NOTED BETWEEN THESE CONSTRUCTION DOCUMENTS AND INFORMATION PROVIDED OR AN ERROR IS SUSPECT, IT SHALL BE REPORTED IMMEDIATELY TO THE CONSTRUCTION MANAGER.

UTILITY NOTES:

1. WORK ASSOCIATED WITH THIS PACKAGE IS FOR TREE FELLING. UTILITY CONFLICTS ARE NOT ANTICIPATED FOR THIS SCOPE OF WORK FOR TREE FELLING. SHOULD UTILITIES BE DISTURBED WITH TREE FELLING, CONTRACTOR WILL REPAIR WITH KIND MATERIALS.
2. THE CONTRACTOR SHALL CONSULT THE OWNER IF THE UTILITY NEEDS TO BE CONTACTED.
3. ANY REFERENCES TO EXISTING UTILITIES ARE THE APPROXIMATE LOCATION AND SIZE. THE CONTRACTOR SHALL VERIFY THE LOCATIONS OF WHICH MAY CONFLICT WITH WORK BY HAND DIGGING TEST PITS BEFORE COMMENCING WORK CLOSE TO UNDERGROUND UTILITIES, UTILITY VAULTS, AND MANHOLES AS INDICATED ON DRAWINGS.

EROSION & SEDIMENT CONTROL NOTES:

1. ALL EROSION CONTROL MEASURES SHALL BE IN ACCORDANCE WITH THE ARTICLE VIII SITING PERMIT, WATER QUALITY CERTIFICATION, NEW YORK STANDARDS AND SPECIFICATIONS FOR EROSION AND SEDIMENT CONTROL, AND LOCAL GOVERNING SOIL AND WATER CONSERVATION AGENCY RECOMMENDATIONS AND STANDARDS. ALL SEDIMENTATION BARRIERS AND OTHER TEMPORARY OR PERMANENT MEASURES SHALL BE IN PLACE PRIOR TO THE START OF CONSTRUCTION. PLANS SHOW THE SUGGESTED MINIMUM MEASURES REQUIRED.
2. REMOVAL OF ALL TEMPORARY EROSION AND SEDIMENTATION CONTROL MEASURES SHALL BE COMPLETED AT THE APPROVAL OF THE OWNER, ENVIRONMENTAL AND AGRICULTURAL MONITOR, AND ENGINEER/QUALIFIED SWPPP INSPECTOR. THE COST OF REMOVING THESE MEASURES SHALL ALSO BE INCLUDED IN THE BID PRICE.
3. FOR THE DURATION OF THE FACILITY, THE CONTRACTOR SHALL PROTECT ALL ON-SITE, ADJACENT AND/OR DOWNSTREAM STORM/SANITARY SEWERS, AND/OR OTHER WATER COURSES FROM CONTAMINATION BY WATER BORNE SILTS, SEDIMENTS, FUELS, SOLVENTS, LUBRICANTS OR OTHER POLLUTANTS ORIGINATING FROM ANY WORK DONE ON, OR IN SUPPORT OF THIS FACILITY.
4. ALL METHODS AND EQUIPMENT PROPOSED BY THE CONTRACTOR TO ACCOMPLISH THE WORK FOR EROSION AND POLLUTION CONTROL SHALL BE SUBJECT TO THE APPROVAL OF THE ENGINEER.
5. ALL AREAS OF SOIL DISTURBANCE RESULTING FROM THIS FACILITY WHICH WILL NOT BE SUBJECT TO FURTHER EARTHWORK OR CONSTRUCTION ACTIVITIES SHALL BE PERMANENTLY SEEDED TO ESTABLISH GRASS AND MULCHED WITH STRAW WITHIN (1) WEEK OF FINAL DISTURBANCE. MULCH SHALL BE MAINTAINED UNTIL A SUITABLE VEGETATIVE COVER IS ESTABLISHED. HAY MULCH IS NOT A PERMITTED FORM OF STABILIZATION, COORDINATE WITH THE ENGINEER FOR ALTERNATIVE METHODS OF STABILIZATION.
6. INSTALL COMPOST FILTER SOCK PARALLEL TO CONTOURS AND IN ACCORDANCE WITH THE BLUE BOOK THROUGHOUT DISTURBED AREAS TO PREVENT EROSION DURING CONSTRUCTION.
7. INSTALL TEMPORARY SEEDING ACCORDING TO THE NYSDEC BLUE BOOK FOR EROSION AND SEDIMENT CONTROL - SECTION 4.
8. SITE ACCESS POINTS SHALL BE ESTABLISHED USING TIMBER MATS TO PROVIDE STABLE ACCESS FOR CONSTRUCTION VEHICLES. THEY WILL SERVE AS THE PRIMARY LOCATION FOR OFFLOADING MATERIALS AND EQUIPMENT. COMPOST FILTER SOCK AND APPROPRIATE EROSION AND SEDIMENT CONTROL MEASURES SHALL BE PLACED ALONG AND IN DOWNSLOPE AREAS TO PROTECT ADJACENT STREAM CORRIDORS.
9. INVASIVE SPECIES CLEANING STATIONS TO BE ESTABLISHED IN PROXIMITY TO INVASIVE SPECIES POPULATIONS. FINAL LOCATIONS TO BE DETERMINED BASED ON FIELD CONDITIONS AND THROUGH CONSULTATION WITH THE EM. TO MINIMIZE THE SPREAD OF INVASIVE PLANT SPECIES, STRICT ADHERENCE TO THE INVASIVE SPECIES CONTROL AND MANAGEMENT PLAN SHOULD BE EMPLOYED THROUGHOUT FACILITY CONSTRUCTION AND RESTORATION. ALL CONSTRUCTION EQUIPMENT MUST BE CLEAN UPON ARRIVAL ON SITE AND SHOULD BE CLEANED PRIOR TO MOVING TO ANOTHER SITE. SOIL FROM AREAS WITH DOCUMENTED INVASIVE SPECIES OCCURRENCE (EVEN IF LIMITED) SHOULD BE NOT STORED OR DISPOSED OF OUTSIDE THE SITE BOUNDARIES. TO MINIMIZE THE CHANCE OF INVASIVE SPECIES SPREADING OR INCREASING IN ABUNDANCE, ALL DISTURBED SOILS WITHIN AND ADJACENT TO THESE AREAS SHOULD BE STABILIZED WITH AN APPROPRIATE SEED MIX AND WEED-FREE MULCH (E.G., STRAW OR CELLULOSE FIBER) OR WOOD CHIPS, SOON AS POSSIBLE. ADDITIONAL TREATMENT TO REMOVE INVASIVE SPECIES POPULATIONS COULD ALSO INCLUDE MANUAL/MECHANICAL REMOVAL OR HERBICIDE APPLICATION. FOR SPECIFIC TREATMENT AND DISPOSAL METHODS, REFERENCE THE INVASIVE SPECIES CONTROL AND MANAGEMENT PLAN.

ACTIVE AGRICULTURAL AND PASTURE AREA NOTES:

1. IN ACTIVE AGRICULTURAL AND PASTURE AREAS CONTRACTOR SHALL PERFORM ALL ACTIVITIES IN ACCORDANCE WITH THE STANDARDS OUTLINED IN THE NEW YORK STATE DEPARTMENT OF AGRICULTURE AND MARKETS "GUIDELINES FOR SOLAR ENERGY PROJECTS" REV 10.19, THE ARTICLE VIII SITING PERMIT, AND ANY APPROVED AGRICULTURAL MITIGATION PLAN.
2. IN ACTIVE PASTURE AREAS THE CONTRACTOR SHALL INSTALL TEMPORARY FENCE AND PROVIDE TEMPORARY LIVESTOCK AND FARM EQUIPMENT CROSSINGS (OR TRENCH PLUGS) WHERE REQUESTED AND/OR NEEDED BY FARM OWNER/OPERATOR.
3. THE CONTRACTOR SHALL REPAIR AND RESTORE ANY DRAIN TILE DAMAGED FROM SITE ACTIVITIES IN ACCORDANCE WITH THE DRAINAGE REMEDIATION PLAN SUBMITTED AS PART OF THE ARTICLE VIII APPLICATION.
4. LOW IMPACT VEHICLES ONLY IN ACTIVE AGRICULTURAL AREAS. TIMBER MATTING WILL BE UTILIZED WHERE VISIBLE SOIL COMPACTION OCCURS OR WHERE RUTTING IS GENERALLY OVER 4-INCHES IN DEPTH.

PROTECTION OF PROPERTY NOTES:

1. ALL CONSTRUCTION ACTIVITY MUST TAKE PLACE WITHIN THE LIMITS OF DISTURBANCE (LOD) AS DEPICTED ON THESE DRAWINGS. CONSTRUCTION ACTIVITY IS PROHIBITED WITHIN AREAS TO BE LEFT IN A NATURAL CONDITION OR AREAS NOT PERMITTED BY THE APPROVED ISSUED PERMITS.

ENVIRONMENTALLY SENSITIVE AREA PROTECTION NOTES:

1. IN THE EVENT THAT ARCHAEOLOGICAL MATERIALS, HUMAN REMAINS, OR EVIDENCE OF HUMAN BURIALS ARE ENCOUNTERED DURING CONSTRUCTION, ALL WORK WITHIN THE VICINITY OF THE FIND WILL BE IMMEDIATELY HALTED AND THE UNANTICIPATED DISCOVERY PLAN WILL BE IMPLEMENTED.
2. NO CONSTRUCTION ACTIVITIES ARE ALLOWED OUTSIDE THE LIMIT OF DISTURBANCE. NO STUMP REMOVAL, GRUBBING, GRADING, EXCAVATION, ROOT-RAKING, HERBICIDE APPLICATION, NEW ACCESS, OR FILL PLACEMENT.
3. ALL FELLING SHALL BE MECHANIZED (FELLER-BUNCHER OR EXCAVATOR WITH SHEAR/SAW/GRAPPLE-SAW). NO HAND FELLING.
4. TREES IN ESAs SHALL BE FELLED, CONTROLLED, SECTIONED, AND LIFTED/CARRIED TO EXISTING ROADS/PADS FOR PROCESSING.
5. STUMPS/ROOTS SHALL REMAIN; CUT STUMPS TO ≤ 6 IN. ABOVE EXISTING GRADE. NO STUMP PULLING OR GRINDING.
6. NO CHIPPING/BROADCASTING WITHIN ESAs; PROCESS/DECK ONLY AT DESIGNATED LOCATIONS OUTSIDE ESA BUFFERS.
7. IF RUTTING EXCEEDS 3 IN. OR SOIL DISPLACEMENT OCCURS, STOP WORK. DO NOT INTRODUCE MATS. RESUME ONLY UNDER DRY/FIRM/FROZEN CONDITIONS.
8. MAINTAIN SETBACKS; NO NEW CROSSINGS OR FORDINGS; NO FUELING/MAINTENANCE IN BUFFERS; SPILL KITS REQUIRED ON-SITE.
9. PROVIDE AT ON-SITE AND IN RADIO CONTACT DURING CLEARING IN ESAs. AT HAS DIRECT STOP-WORK AUTHORITY FOR TRIGGERS PER CRAMMP/UDP (INCLUDING LITHICS, CERAMICS, CHARCOAL LENSES/HEARTHS, SOIL STAINS/FEATURES, SHELL MIDDENS, HISTORIC ARTIFACT/DEBRIS CONCENTRATIONS, FOUNDATIONS/STRUCTURAL REMAINS, AND ANY HUMAN REMAINS). UPON TRIGGER: STOP WORK WITHIN THE VICINITY, SECURE EQUIPMENT, ESTABLISH EXCLUSION ZONE PER UDP/CRAMMP, NOTIFY SUPERINTENDENT, PI, AND OWNER'S ENVIRONMENTAL REP; DOCUMENT GPS/CONTEXT; FOLLOW HUMAN-REMAINS PROTOCOL AS APPLICABLE. WORK SHALL NOT RESUME IN THE EXCLUSION ZONE UNTIL WRITTEN CLEARANCE IS ISSUED BY THE PI (AND ANY REQUIRED EXTERNAL APPROVALS ARE RECEIVED).

WETLAND AND STREAM AVOIDANCE, MINIMIZATION, AND PROTECTION NOTES:

1. WETLAND AND BUFFER BOUNDARIES SHALL BE FIELD-DELINEATED AND FLAGGED PRIOR TO CONSTRUCTION.
2. ALL EQUIPMENT ENTERING THE SITE SHALL BE CLEAN AND FREE OF SOIL/PLANT MATERIAL TO PREVENT INVASIVE SPECIES INTRODUCTION.
3. WHERE MECHANICAL EQUIPMENT MUST CROSS WETLANDS OR STREAMS, THE CROSSING SHALL BE LIMITED TO THE MINIMUM WIDTH NECESSARY FOR EQUIPMENT AND SHALL BE PROTECTED USING TIMBER MATS OR COMPOSITE MATS.
4. SILT SOCKS SHALL BE INSTALLED AT THE DOWN-GRADIENT EDGE OF THE BUFFER AND ALONG THE ACCESS PATH TO PREVENT SEDIMENT MIGRATION. SILT FENCE SHALL BE USED ONLY IN UPLAND AREAS WHERE APPROPRIATE.
5. TREES WITHIN WETLAND AND STREAMS ARE TO BE CUT BY HAND AND WETLANDS AND STREAMS ARE TO BE PROTECTED FROM DISTURBANCE. NO MECHANICAL EQUIPMENT IS ALLOWED WITHIN WETLANDS EXCEPT AT MATTED CROSSINGS.
6. NO STUMP REMOVAL SHALL OCCUR WITHIN WETLANDS OR STREAMS. ALL STUMPS SHALL BE CUT FLUSH TO GROUND AND LEFT IN PLACE.
7. REFUELING, STORAGE, AND MAINTENANCE OF EQUIPMENT SHALL OCCUR OUTSIDE WETLANDS AND BUFFERS.
8. FOLLOWING CLEARING, ALL DISTURBED SOILS SHALL BE STABILIZED IMMEDIATELY WITH APPROVED SEED MIX AND WEED-FREE MULCH.
9. CONTRACTOR SHALL INSPECT AND MAINTAIN ALL EROSION AND SEDIMENT CONTROL MEASURES UNTIL FINAL STABILIZATION IS ACHIEVED.
10. MONITOR DISTURBED AREAS FOR INVASIVE SPECIES AND IMPLEMENT CONTROL MEASURES AS REQUIRED BY THE INVASIVE SPECIES CONTROL AND MANAGEMENT PLAN.
11. CONTRACTOR SHALL BE RESPONSIBLE FOR MONITORING AND MAINTAINING WETLAND AREAS IMPACTED BY TEMPORARY CONSTRUCTION MATTING, INCLUDING WHERE MATS REMAIN IN PLACE FOR EXTENDED DURATIONS. CONTRACTOR SHALL IMPLEMENT CORRECTIVE MEASURES AS NECESSARY TO PREVENT DEGRADATION OF WETLAND CONDITIONS IN ACCORDANCE WITH THE SWPPP AND PERMIT REQUIREMENTS.
12. WHERE TEMPORARY CONSTRUCTION MATTING REMAINS IN WETLAND AREAS FOR EXTENDED PERIODS, THE CONTRACTOR SHALL BE RESPONSIBLE FOR MONITORING WETLAND CONDITIONS AND ADDRESSING ANY ADVERSE IMPACTS IN ACCORDANCE WITH THE SWPPP AND APPLICABLE PERMIT REQUIREMENTS.

ENVIRONMENTAL PROTECTION NOTES:

1. NOISE IMPACTS FROM CONSTRUCTION SHALL BE MINIMIZED AND MITIGATED TO THE EXTENT PRACTICABLE AND SHALL COMPLY WITH THE SITING PERMIT SECTION 5.4. CONTRACTOR SHALL MAINTAIN ALL EQUIPMENT IN GOOD OPERATING CONDITIONS AND ALL MOTORS AND ENGINES WILL BE MUFFLED ACCORDING TO MANUFACTURER'S SPECIFICATIONS AND WILL COMPLY WITH STATE ENVIRONMENTAL LAW, SUBCHAPTER E, PART 450 (NOISE FROM HEAVY MOTOR VEHICLES). ANY FAULTY NOISE SUPPRESSOR WILL BE REPAIRED OR REPLACED; EQUIPMENT WILL NOT BE LEFT RUNNING UNNECESSARILY.
2. CONSTRUCTION WORK SHALL BE LIMITED TO THE HOURS OF 7:00 A.M. TO 8:00 P.M. FROM MONDAY THROUGH SATURDAY, AND 8:00 A.M. TO 8:00 P.M. ON SUNDAYS AND NATIONAL HOLIDAYS. FOR CERTAIN CONSTRUCTION PHASES AND ACTIVITIES, ADDITIONAL WORK HOURS MAY BE NECESSARY AND SHALL BE NOTIFIED IN ACCORDANCE WITH THE ARTICLE VIII SITING PERMIT.
3. NO GRADING OR SIGNIFICANT GROUND DISTURBANCE IS ALLOWED WITHIN ESAs. SIGNIFICANT GROUND DISTURBANCE IS DEFINED AS EXCAVATION OR GRADING MORE THAN 6" DEEP, GRUBBING OR STUMP REMOVAL, AND TRENCHING WIDER THAN 1'.
4. CONTRACTOR TO HAVE FLAGGING IN PLACE FOR ESAs PRIOR TO TREE FELLING. FLAGGING FOR ESAs SHALL CONSIST OF COLORED FLAGGING, "PROTECTED AREA" SIGNS, OR EROSION AND SEDIMENT CONTROL MEASURES SPECIFIED BY THE SWPPP. IF NECESSARY TO PREVENT ACCESS BY MOTORIZED VEHICLES INTO ESAs WHERE NO CONSTRUCTION IS PLANNED, THE CONTRACTOR SHALL INSTALL ADDITIONAL MARKERS OR SIGNS STATING, "NO EQUIPMENT ACCESS."

CONSTRUCTION MITIGATION FOR AGRICULTURAL LANDS NOTES:

1. THE EM/AM/SWPPP INSPECTOR WILL OVERSEE AND ENSURE THAT ALL CONSTRUCTION ACTIVITIES ARE COMPLIANT WITH AGRICULTURAL CONDITIONS AND REQUIREMENTS SET FORTH IN THE ARTICLE VIII SITING PERMIT, INCLUDING THE APPROVED AGRICULTURAL REMEDIATION PLAN AND AGRICULTURAL CO-UTILIZATION PLAN.
2. WORK ASSOCIATED WITH THIS PACKAGE IS FOR TREE FELLING. GRADING ACTIVITIES ARE NOT ANTICIPATED FOR THIS SCOPE OF WORK FOR TREE FELLING. IF MINOR GROUND DISTURBANCE OCCURS DURING TREE FELLING, THE CONTRACTOR WILL REPAIR GROUND DISTURBANCE AND NOTIFY THE OWNER.

TRAFFIC CONTROL NOTES:

1. THE CONTRACTOR SHALL CONDUCT THE WORK IN A MANNER THAT WILL ENSURE, AS FAR AS PRACTICABLE, THE LEAST OBSTRUCTION TO TRAFFIC AND SHALL PROVIDE FOR THE CONVENIENCE AND SAFETY OF THE GENERAL PUBLIC AND VISITORS, ALONG AND ADJACENT TO HIGHWAYS IN THE CONSTRUCTION AREA, IN AN ADEQUATE AND SATISFACTORY MANNER.
2. REFERENCES TO NYSDOT STANDARDS SHALL MEAN THE VERSION OF THE "STANDARD SPECIFICATIONS, CONSTRUCTION AND MATERIALS, OFFICE OF ENGINEERING, NEW YORK STATE DEPARTMENT OF TRANSPORTATION", CURRENT ON THE BID DATE WITH ALL CURRENT ADDENDUMS.
3. CONTRACTORS SHALL NOT PARK VEHICLES OR EQUIPMENT ON PUBLIC ROADS FOR ANY EXTENDED PERIOD OF TIME. PARKING DURING WORK HOURS OR OVERNIGHT SHALL OCCUR AT SITE ACCESS POINTS. THE LOCATION OF PARKING AREAS SHOWN ON THE DRAWINGS MAY BE MODIFIED IN COORDINATION WITH THE ENVIRONMENTAL MONITOR AND/OR AGENCY STAFF AS LONG AS ADDITIONAL RESOURCE IMPACTS ARE AVOIDED.
4. CONTRACTORS SHALL MINIMIZE USE OF PUBLIC ROADS AFTER DARK, TO THE EXTENT PRACTICABLE.
5. TEMPORARY SIGNAGE, IF REQUIRED, WILL CONFORM TO THE SPECIFICATIONS OF SHAPE, COLOR, REFLECTIVITY, MESSAGE, AND SIZE, AS SPECIFIED BY NYSDOT REQUIREMENTS. ALL SIGNAGE SHALL BE COVERED WHEN NOT IN USE.

MULCHING RATE:

USE STRAW (CEREAL GRAIN) MULCH AT THE RATE OF:
(2) TONS PER ACRE, OR
(90) LBS. PER 1,000 SF, OR
(2-3) BALES PER 1,000 SF

MULCH ANCHORING REQUIREMENTS:

ON SLOPES GREATER THAN 3 PERCENT, STRAW MULCH WILL BE FIRMLY ANCHORED INTO THE SOIL UTILIZING ONE OF THE FOLLOWING METHODS:

- CRIMPING WITH A STRAIGHT OR NOTCHED MULCH CRIMPING TOOL (FARM DISCS WILL NOT BE ALLOWED);
- TRACK WALKING WITH DEEP-CLEATED EQUIPMENT OPERATING UP AND DOWN THE SLOPE (MULCH CRIMPED PERPENDICULAR TO THE SLOPE) ON SLOPES <25 PERCENT;
- APPLICATION OF MULCH NETTING;
- APPLICATION OF 500 LB./ACRE OF WOOD FIBER MULCH OVER STRAW/ HAY MULCH; AND
- COMMERCIALLY AVAILABLE TACKIFIERS (EXCEPT WITHIN 100 FEET OF WATER BODIES OR WETLANDS).

MAINTENANCE OF EROSION CONTROL MEASURES:

PERMANENT VEGETATION:

INSPECT ALL AREAS THAT HAVE RECEIVED VEGETATION EVERY SEVEN DAYS AND AFTER EVERY RAIN EVENT. ALL AREAS DAMAGED BY EROSION OR WHERE SEED HAS NOT ESTABLISHED SHALL BE REPAIRED AND RESTABILIZED IMMEDIATELY.

PERMANENT SEEDING:

PERMANENT SEEDING PREVENTS SOIL EROSION FROM EXPOSED SOILS. SEEDING SHALL BE PLACED WHERE CONSTRUCTION WORK IS COMPLETE IN A DISTURBED AREA AND NO FURTHER SOIL DISTURBANCE WILL OCCUR. PERMANENT SEED SHALL BE PLACED WITHIN 14 DAYS AFTER W0RK HAS BEEN COMPLETED IN THE DISTURBED AREA.

EROSION CONTROL MEASURES:

EROSION AND SEDIMENT CONTROL MEASURES SHALL CONSIST OF PROVIDING AND MAINTAINING COMPOST FILTER SOCKS, DOWNGRADIENT OF ALL TREE FELLING AREAS. ALL ESC MATERIALS SHALL BE NEW AND FREE FROM DEFECTS THAT WOULD COMPROMISE THE EFFECTIVENESS OF THE CONTROL MEASURES. AFTER COMPLETION, ALL MATERIAL SHALL BE DISPOSED OF PROPERLY. LOCATION OF EROSION AND SEDIMENT CONTROL STRUCTURES CAN BE SEEN ON THE TREE FELLING PLANS (SEE LEGEND - PROPOSED CONDITIONS).

TEMPORARY LAYDOWN YARD INSTALLATION

1. FIVE-ACRE DISTURBANCE LIMIT: AT NO TIME SHALL ACTIVE SOIL DISTURBANCE EXCEED FIVE (5) ACRES. CONSTRUCTION OF THE TEMPORARY LAYDOWN YARD SHALL PROCEED IN PHASES. EACH PHASE SHALL BE STABILIZED IN ACCORDANCE WITH THE APPROVED SWPPP BEFORE EARTH DISTURBANCE BEGINS WITHIN A SUBSEQUENT PHASE.
2. PRIOR TO COMMENCING EARTH DISTURBANCE WITHIN EACH PHASE, ESTABLISH THE LIMITS OF DISTURBANCE AND INSTALL ALL REQUIRED EROSION AND SEDIMENT CONTROL MEASURES IN ACCORDANCE WITH THE APPROVED PLANS AND SWPPP.
3. STRIP TOPSOIL FROM THE TEMPORARY LAYDOWN YARD AREA AND STOCKPILE IT SEPARATELY WITHIN THE DESIGNATED TOPSOIL STOCKPILE AREAS FOR REUSE DURING SITE RESTORATION. STABILIZE STOCKPILES IN ACCORDANCE WITH THE EROSION AND SEDIMENT CONTROL PLANS.
4. PROOF-ROLL AND PREPARE THE EXPOSED SUBGRADE. REMOVE UNSUITABLE MATERIAL AND ADDRESS SOFT OR UNSTABLE AREAS AS DIRECTED BY THE ENGINEER.
5. PLACE GEOTEXTILE SEPARATION FABRIC OVER THE PREPARED SUBGRADE. INSTALL GEOTEXTILE IN ACCORDANCE WITH THE MANUFACTURER'S RECOMMENDATIONS, INCLUDING REQUIRED OVERLAPS AND REPAIRS.
6. PLACE, GRADE, AND COMPACT THE SPECIFIED AGGREGATE SURFACE OVER THE GEOTEXTILE. MAINTAIN POSITIVE DRAINAGE AND PREVENT THE FORMATION OF ISOLATED LOW POINTS.
7. CONSTRUCT TEMPORARY TRAILER PADS, PARKING AREAS, MATERIAL STORAGE AREAS, AND INTERNAL CIRCULATION ROUTES AS SHOWN ON THE PLANS.
8. MAINTAIN THE LAYDOWN YARD, DRAINAGE FEATURES, AND EROSION AND SEDIMENT CONTROLS THROUGHOUT CONSTRUCTION. REPAIR DISPLACED AGGREGATE, EXPOSED GEOTEXTILE, RUTTING, AND AREAS OF PONDING AS NECESSARY.
9. UPON COMPLETION OF CONSTRUCTION, REMOVE ALL TEMPORARY IMPROVEMENTS, INCLUDING AGGREGATE, GEOTEXTILE, FENCING, TRAILERS, AND ASSOCIATED FACILITIES. DECOMPACT THE SUBGRADE, REPLACE STOCKPILED TOPSOIL, RESTORE PRE-EXISTING GRADES AND DRAINAGE PATTERNS, AND PERMANENTLY STABILIZE THE AREA.

LEGEND

PROPOSED CONDITIONS:

- TREE/SCRUB/SHRUB CLEARING TYPE I (UPLAND)
- TREE/SCRUB/SHRUB CLEARING & GRUBBING TYPE I
- TREE/SCRUB/SHRUB CLEARING TYPE II (WETLAND)
- MATTED STAGING AREA
- LOD — PERMITTED LIMITS OF DISTURBANCE
- TIMBER MAT ACCESS ROAD
- SITE ACCESS POINT / STABILIZED CONSTRUCTION ENTRANCE
- EXISTING ACCESS ROUTE TO CLEARING AREAS
- LOG STOCKPILE AREA
- FS — COMPOST FILTER SOCK
- SSF — SUPER SILT FENCE
- OCSF — ORANGE CONSTRUCTION SAFETY FENCE
- PROPOSED MAJOR CONTOUR
- PROPOSED MINOR CONTOUR
- TEMPORARY AG FENCE

EXISTING CONDITIONS:

- EXISTING BUILDING
- PARTICIPATING PROPERTY LINE
- NON-PARTICIPATING PROPERTY LINE
- EXISTING PUBLIC ROAD RIGHT-OF-WAY
- EXISTING MUNICIPALITY BOUNDARY LINES
- EXISTING UTILITY EASEMENT LINES
- OVH — EXISTING OVERHEAD ELECTRIC UTILITY LINES & POLES & STEEL TOWER
- UGE — EXISTING UNDERGROUND ELECTRIC UTILITY LINES
- UGT — EXISTING UNDERGROUND TELEPHONE UTILITY LINES
- COMM — EXISTING UNDERGROUND COMMUNICATION UTILITY LINES
- EXISTING GAS UTILITY LINES & VALVES & MARKERS
- W — EXISTING WATER UTILITY LINES & HYDRANTS
- SAN — EXISTING SANITARY SEWER UTILITY LINES & MANHOLES
- EXISTING MISCELLANEOUS UTILITY MANHOLES
- X — EXISTING FENCE LINES
- EXISTING RAILROAD LINE
- EXISTING ORES WETLAND BUFFERS 100'
- ST010 R6 - Ephemeral — EXISTING STREAM CENTERLINES & EMBANKMENTS
- ENVIRONMENTALLY SENSITIVE AREA
- EXISTING KARST FEATURE MARKER, AREA & BUFFER AREA
- 022 PEM — EXISTING WETLAND (NO ANTICIPATED STATE OR FEDERAL JURISDICTION) & WETLAND CONTINUES (ORANGE LINE)
- 022 PEM — EXISTING WETLAND (STATE JURISDICTION) & WETLAND CONTINUES (ORANGE LINE)
- 022 PEM — EXISTING WETLAND (ANTICIPATED USACE JURISDICTION) & WETLAND CONTINUES (ORANGE LINE)
- 015 POW — EXISTING POND
- 720 — EXISTING MAJOR CONTOUR
- 719 — EXISTING MINOR CONTOUR

NOTE, ISOLATED TREES AND UPLAND GRUBBING (THROUGH COORDINATION WITH ENV. MONITOR) MAY EXIST OUTSIDE OF SPECIFIED TREE CLEARING LOCATIONS BUT WITHIN THE LIMIT OF DISTURBANCE (LOD). THE CONTRACTOR IS TO REVIEW THE ENTIRE LOD TO ENSURE ALL TREES GREATER THAN 3-INCHES IN BREAST DIAMETER HEIGHT ARE REMOVED PRIOR TO MARCH 31 IN AN EFFORT TO AVOID TREE CLEARING RESTRICTIONS. ISOLATED TREES ARE ANTICIPATED TO BE HAND FELLED AND LEFT IN PLACE UNLESS EQUIPMENT IS ABLE TO ACCESS THESE LOCATIONS WITHOUT ADVERSE IMPACT.

Dig Safely. New York Call 811 before you dig

aes
2180 South 1300 East, Suite 600
Salt Lake City, UT 84106-2749
(801) 679 - 3500

TRC
249 Western Avenue
Augusta, ME 04330


PE STAMP:

STATE OF NEW YORK · DANIEL T BUTLER · 079800 · LICENSED PROFESSIONAL ENGINEER

10/22/2026

UNDER NEW YORK STATE EDUCATION LAW ARTICLE 145 (ENGINEERING), SECTION 7209(2), IT IS A VIOLATION OF THE LAW FOR ANY PERSON, UNLESS ACTING UNDER THE DIRECTION OF A LICENSED PROFESSIONAL ENGINEER, TO ALTER THIS DOCUMENT.

KEY PLAN:

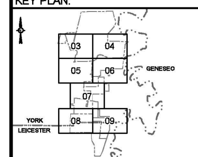

REVISIONS:

	DATE	DESCRIPTION
E	04/08/2026	ISSUED FOR REVIEW
F	04/16/2026	ISSUED FOR REVIEW
G	04/29/2026	ISSUED FOR REVIEW
H	09/11/2026	ADDED LAYDOWN YARD
I	09/16/2026	ADDED SEDIMENT PONDS
J	09/21/2026	REVISED PER CLIENT COMMENTS
K	10/05/2026	ADDED REVISION CLOUDS
L	10/22/2026	ADDED OCSF AROUND ESAs

PROJECT TITLE:

WHITE CREEK SOLAR

PROJECT LOCATION:

TOWN OF YORK &
TOWN OF LEICESTER
LIVINGSTON COUNTY
NEW YORK


SHEET TITLE & DESCRIPTION:

NOTES, LEGEND & DETAILS

ISSUED FOR CONSTRUCTION

PROJ NUM:	666563
DES:	TRC
DWN:	TRC
CHK:	SGL
APV:	-
DATE:	09/08/2025
SCALE AT 22" x 34":	NTS
SHEET NO:	TCP-02
REV:	L

PLOTTED: 10/22/2026 12:05 PM

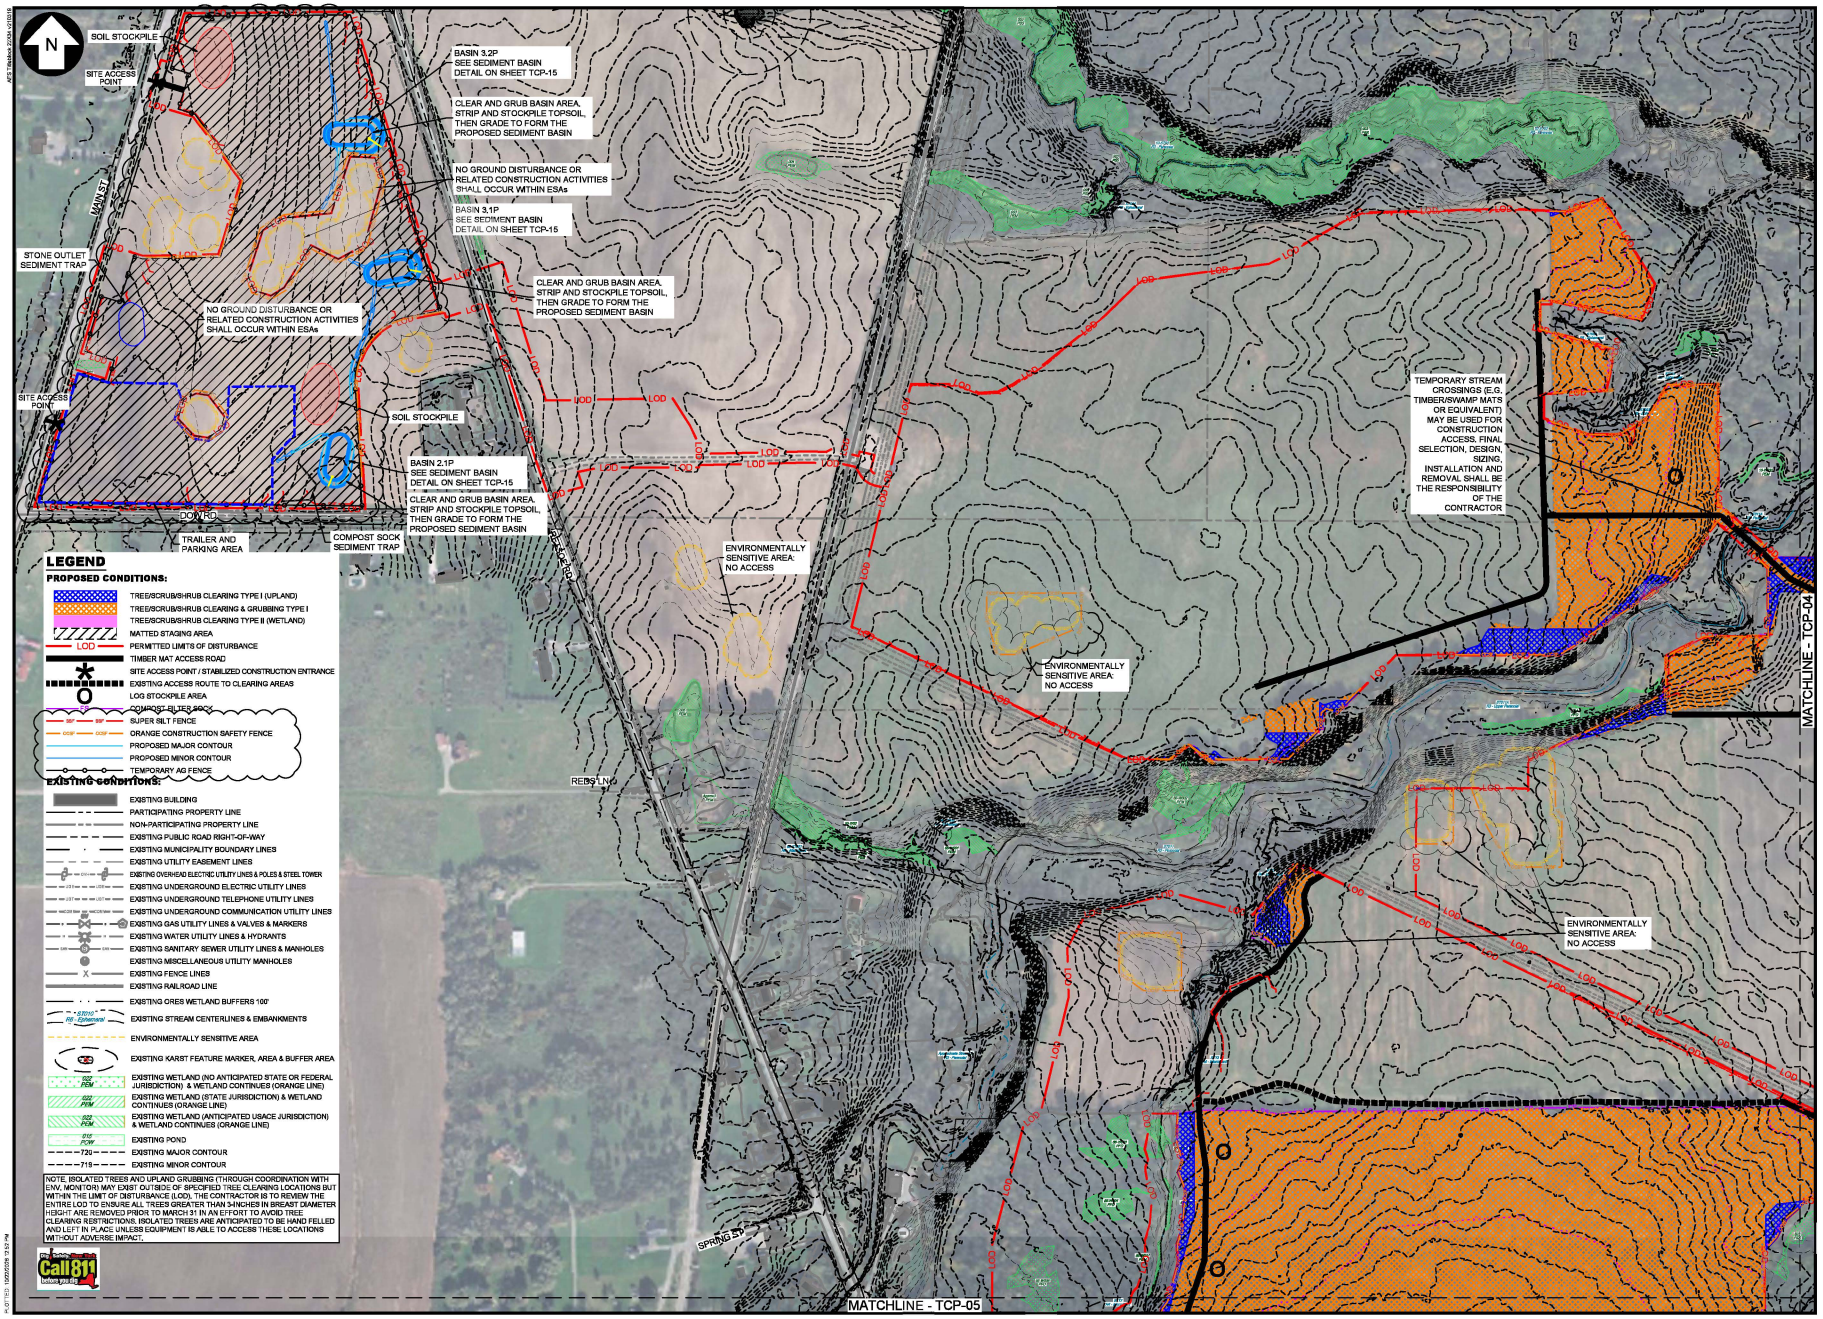


aes
2180 South 1300 East, Suite 600
Salt Lake City, UT 84106-2749
(801) 679 - 3500

TRC
249 Western Avenue
Augusta, ME 04330

PE STAMP:

STATE OF NEW YORK
DANIEL T. BUTLER
079800
LICENSED PROFESSIONAL ENGINEER
UNDER NEW YORK STATE EDUCATION LAW ARTICLE 145 (ENGINEERING), SECTION 7209, IT IS A VIOLATION OF THE LAW FOR ANY PERSON, UNLESS ACTING UNDER THE DIRECTION OF A LICENSED PROFESSIONAL ENGINEER, TO ALTER THIS DOCUMENT.

KEY PLAN:

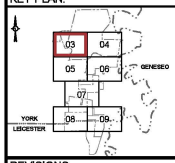

REVISIONS:

	DATE	DESCRIPTION
E	04/08/2026	ISSUED FOR REVIEW
F	04/16/2026	ISSUED FOR REVIEW
G	04/29/2026	ISSUED FOR REVIEW
H	09/11/2026	ADDED LAYDOWN YARD
I	09/16/2026	ADDED SEDIMENT PONDS
J	09/21/2026	REVISED PER CLIENT COMMENTS
K	10/05/2026	ADDED REVISION CLOUDS
L	10/22/2026	ADDED OCSF AROUND ESAs

PROJECT TITLE:

WHITE CREEK SOLAR

PROJECT LOCATION:

TOWN OF YORK &
TOWN OF LEICESTER
LIVINGSTON COUNTY
NEW YORK

SHEET TITLE & DESCRIPTION:


EXISTING CONDITIONS & TREE CLEARING PLAN (1)

ISSUED FOR CONSTRUCTION

PROJ. NUM:	666563
DES:	TRC
DWN:	TRC
CHK:	SGL
APV:	-
DATE:	09/08/2025

SCALE AT 22" x 34":
0 100' 200' 300' 400'
1" = 200'


SHEET NO:	REV:
TCP-03	L

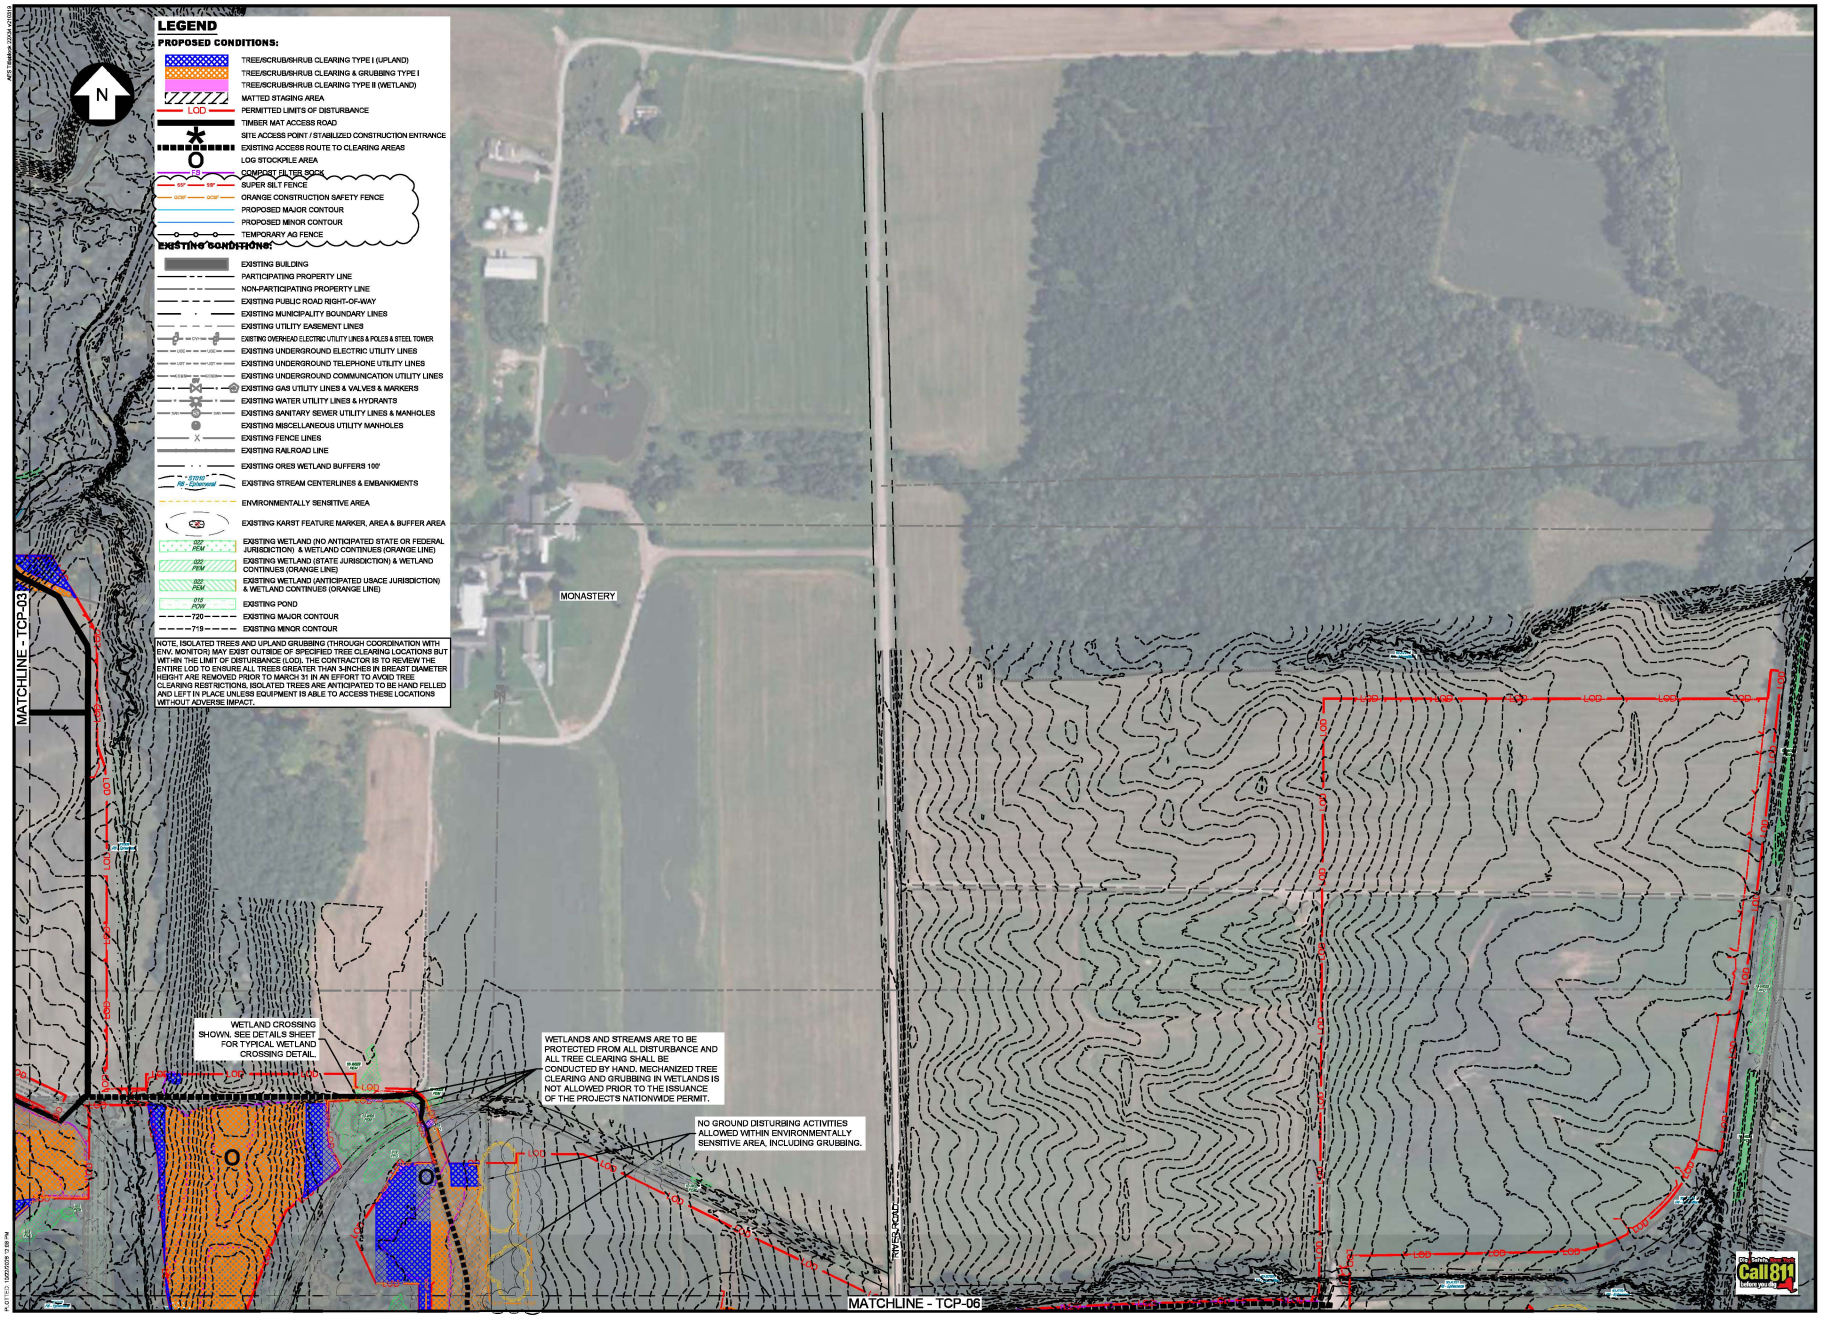

aes
2180 South 1300 East, Suite 600
Salt Lake City, UT 84106-2749
(801) 879 - 3500


TRC
249 Western Avenue
Augusta, ME 04330

PE STAMP:

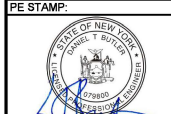

UNDER NEW YORK STATE EDUCATION LAW ARTICLE 145 (ENGINEERING), SECTION 7209, IT IS A VIOLATION OF THE LAW FOR ANY PERSON, UNLESS ACTING UNDER THE DIRECTION OF A LICENSED PROFESSIONAL ENGINEER, TO ALTER THIS DOCUMENT.

KEY PLAN:

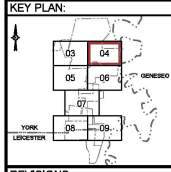

REVISIONS:

	DATE	DESCRIPTION
E	04/08/2026	ISSUED FOR REVIEW
F	04/16/2026	ISSUED FOR REVIEW
G	04/28/2026	ISSUED FOR REVIEW
H	09/11/2026	ADDED LAYDOWN YARD
I	09/16/2026	ADDED SEDIMENT PONDS
J	09/21/2026	REVISED PER CLIENT COMMENTS
K	10/05/2026	ADDED REVISION CLOUDS
L	10/22/2026	ADDED OCSF AROUND ESAs

PROJECT TITLE:

WHITE CREEK SOLAR

PROJECT LOCATION:

TOWN OF YORK &
TOWN OF LEICESTER
LIVINGSTON COUNTY
NEW YORK

SHEET TITLE & DESCRIPTION:

EXISTING CONDITIONS & TREE CLEARING PLAN (2)

ISSUED FOR CONSTRUCTION


PROJ. NUM:	666563
DES:	TRC
DWN:	TRC
CHK:	SGL
APV:	-
DATE:	09/08/2025

SCALE AT 22" x 34":

0 100' 200' 300' 400'

1" = 200'

SHEET NO:	REV:
TCP-04	L

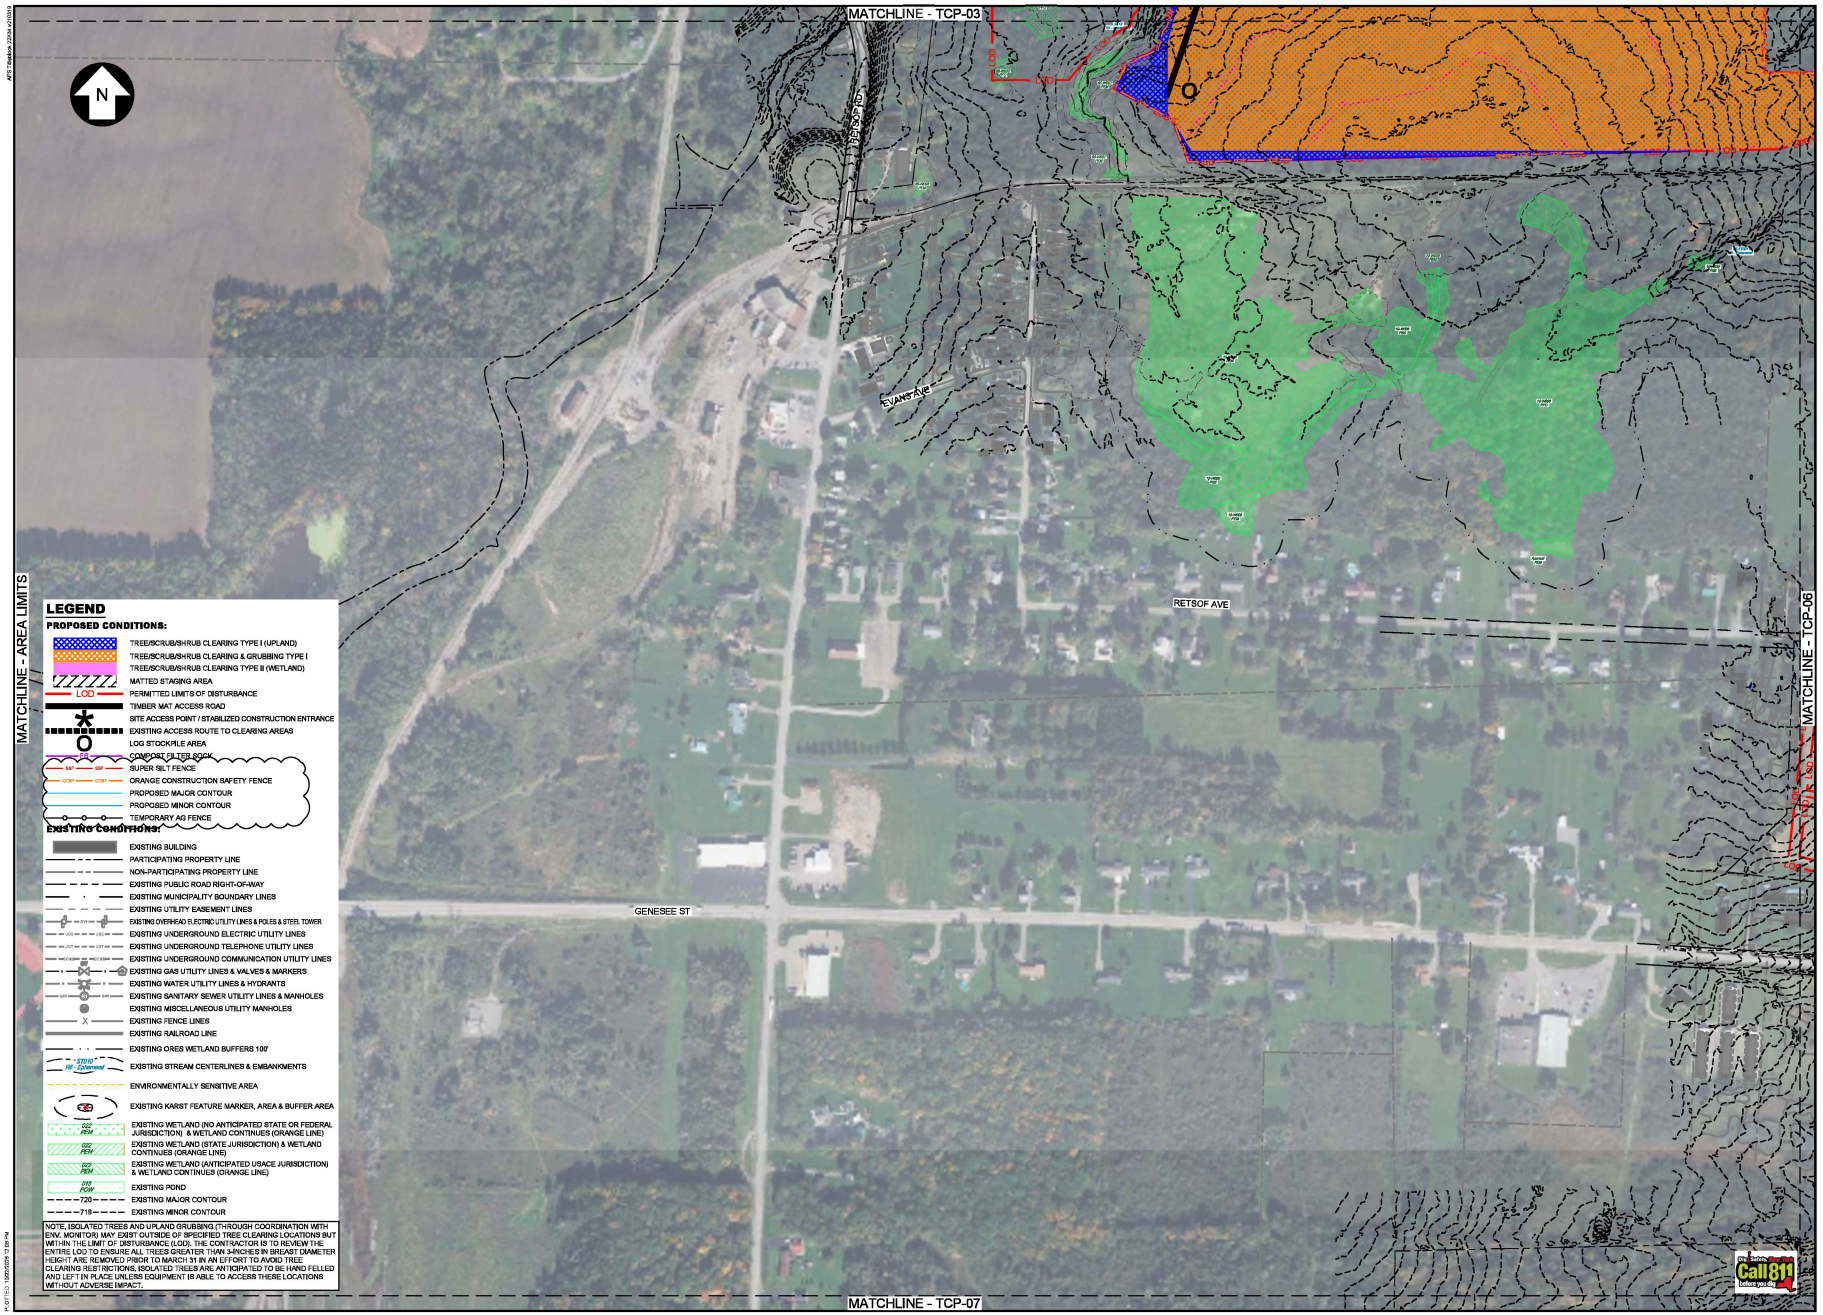

LEGEND

PROPOSED CONDITIONS:

- TREE/SCRUB/SHRUB CLEARING TYPE I (UPLAND)
- TREE/SCRUB/SHRUB CLEARING & GRUBBING TYPE I
- TREE/SCRUB/SHRUB CLEARING TYPE II (WETLAND)
- MATTED STAGING AREA
- LOD — PERMITTED LIMITS OF DISTURBANCE
- TIMBER MAT ACCESS ROAD
- SITE ACCESS POINT / STABILIZED CONSTRUCTION ENTRANCE
- EXISTING ACCESS ROUTE TO CLEARING AREAS
- O — LOG STOCKPILE AREA
- CF — COMPOST FILTER SOCK
- SSF — SUPER SILT FENCE
- OCSF — ORANGE CONSTRUCTION SAFETY FENCE
- PROPOSED MAJOR CONTOUR
- PROPOSED MINOR CONTOUR
- TEMPORARY AG FENCE

EXISTING CONDITIONS:

- EXISTING BUILDING
- PARTICIPATING PROPERTY LINE
- NON-PARTICIPATING PROPERTY LINE
- EXISTING PUBLIC ROAD RIGHT-OF-WAY
- EXISTING MUNICIPALITY BOUNDARY LINES
- EXISTING UTILITY EASEMENT LINES
- EXISTING OVERHEAD ELECTRIC UTILITY LINES & POLES & STEEL TOWER
- EXISTING UNDERGROUND ELECTRIC UTILITY LINES
- EXISTING UNDERGROUND TELEPHONE UTILITY LINES
- EXISTING UNDERGROUND COMMUNICATION UTILITY LINES
- EXISTING GAS UTILITY LINES & VALVES & MARKERS
- EXISTING WATER UTILITY LINES & HYDRANTS
- EXISTING SANITARY SEWER UTILITY LINES & MANHOLES
- EXISTING MISCELLANEOUS UTILITY MANHOLES
- EXISTING FENCE LINES
- EXISTING RAILROAD LINE
- EXISTING ORES WETLAND BUFFERS 100'
- STR-01 RB - Centerline — EXISTING STREAM CENTERLINES & EMBANKMENTS
- ENVIRONMENTALLY SENSITIVE AREA
- KB — EXISTING KARST FEATURE MARKER, AREA & BUFFER AREA
- EXISTING WETLAND (NO ANTICIPATED STATE OR FEDERAL JURISDICTION) & WETLAND CONTINUES (ORANGE LINE)
- EXISTING WETLAND (STATE JURISDICTION) & WETLAND CONTINUES (ORANGE LINE)
- EXISTING WETLAND (ANTICIPATED USACE JURISDICTION) & WETLAND CONTINUES (ORANGE LINE)
- EXISTING POND
- 720 — EXISTING MAJOR CONTOUR
- 719 — EXISTING MINOR CONTOUR

NOTE: ISOLATED TREES AND UPLAND GRUBBING (THROUGH COORDINATION WITH ENV. MONITOR) MAY EXIST OUTSIDE OF SPECIFIED TREE CLEARING LOCATIONS BUT WITHIN THE LIMIT OF DISTURBANCE (LOD). THE CONTRACTOR IS TO REVIEW THE ENTIRE LOD TO ENSURE ALL TREES GREATER THAN 3-INCHES IN BREAST DIAMETER HEIGHT ARE REMOVED PRIOR TO MARCH 31 IN AN EFFORT TO AVOID TREE CLEARING RESTRICTIONS. ISOLATED TREES ARE ANTICIPATED TO BE HAND FELLED AND LEFT IN PLACE UNLESS EQUIPMENT IS ABLE TO ACCESS THERE LOCATIONS WITHOUT ADVERSE IMPACT.

aes
2180 South 1300 East, Suite 600
Salt Lake City, UT 84106-2749
(801) 679 - 3500


TRC
249 Western Avenue
Augusta, ME 04330

PE STAMP:

STATE OF NEW YORK · DANIEL T BUTLER · 079805 · LICENSED PROFESSIONAL ENGINEER

UNDER NEW YORK STATE EDUCATION LAW ARTICLE 145 (ENGINEERING), SECTION 7209, IT IS A VIOLATION OF THE LAW FOR ANY PERSON, UNLESS ACTING UNDER THE DIRECTION OF A LICENSED PROFESSIONAL ENGINEER, TO ALTER THIS DOCUMENT.

KEY PLAN:

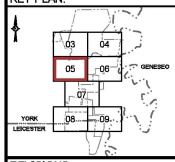

REVISIONS:

	DATE	DESCRIPTION
E	04/08/2026	ISSUED FOR REVIEW
F	04/16/2026	ISSUED FOR REVIEW
G	04/29/2026	ISSUED FOR REVIEW
H	09/11/2026	ADDED LAYDOWN YARD
I	09/16/2026	ADDED SEDIMENT PONDS
J	09/21/2026	REVISED PER CLIENT COMMENTS
K	10/05/2026	ADDED REVISION CLOUDS
L	10/22/2026	ADDED OCSF AROUND ESAs

PROJECT TITLE:

WHITE CREEK SOLAR

PROJECT LOCATION:

TOWN OF YORK &
TOWN OF LEICESTER
LIVINGSTON COUNTY
NEW YORK

SHEET TITLE & DESCRIPTION:

EXISTING CONDITIONS & TREE CLEARING PLAN (3)

ISSUED FOR CONSTRUCTION


PROJ. NUM:	666563
DES:	TRC
DWN:	TRC
CHK:	SGL
APV:	-
DATE:	09/08/2025

SCALE AT 22" x 34":

0 100' 200' 300' 400'

1" = 200'

SHEET NO:	REV:
TCP-05	L

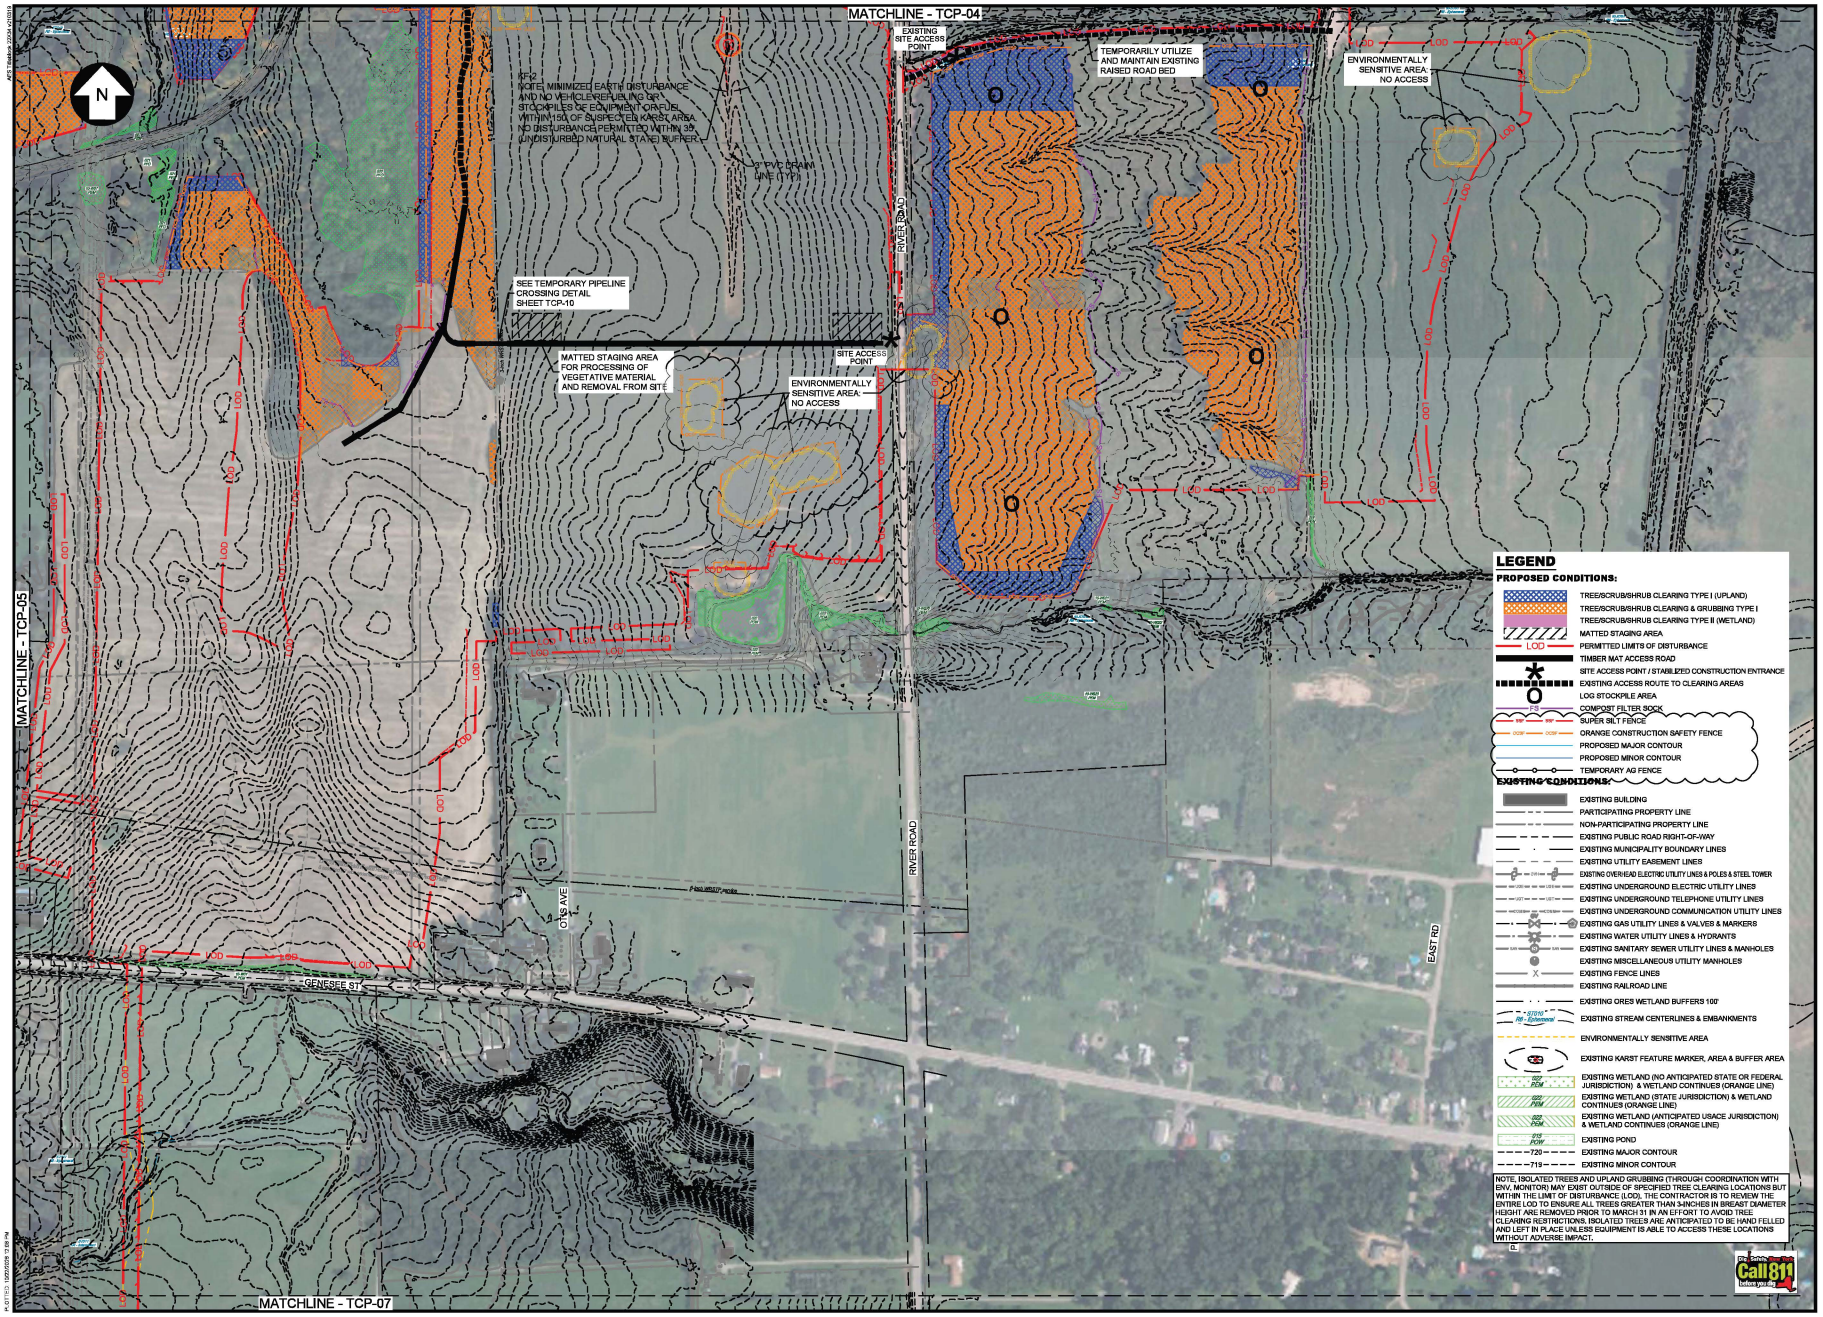

LEGEND

PROPOSED CONDITIONS:

- TREE/SCRUB/SHRUB CLEARING TYPE I (UPLAND)
- TREE/SCRUB/SHRUB CLEARING & GRUBBING TYPE I
- TREE/SCRUB/SHRUB CLEARING TYPE II (WETLAND)
- MATTED STAGING AREA
- LOD — PERMITTED LIMITS OF DISTURBANCE
- TIMBER MAT ACCESS ROAD
- SITE ACCESS POINT / STABILIZED CONSTRUCTION ENTRANCE
- EXISTING ACCESS ROUTE TO CLEARING AREAS
- LOG STOCKPILE AREA
- COMPOST FILTER SOCK
- SSF — SUPER SILT FENCE
- OCSF — ORANGE CONSTRUCTION SAFETY FENCE
- PROPOSED MAJOR CONTOUR
- PROPOSED MINOR CONTOUR
- TEMPORARY AG FENCE

EXISTING CONDITIONS:

- EXISTING BUILDING
- PARTICIPATING PROPERTY LINE
- NON-PARTICIPATING PROPERTY LINE
- EXISTING PUBLIC ROAD RIGHT-OF-WAY
- EXISTING MUNICIPALITY BOUNDARY LINES
- EXISTING UTILITY EASEMENT LINES
- EXISTING OVERHEAD ELECTRIC UTILITY LINES & POLES & STEEL TOWER
- EXISTING UNDERGROUND ELECTRIC UTILITY LINES
- EXISTING UNDERGROUND TELEPHONE UTILITY LINES
- EXISTING UNDERGROUND COMMUNICATION UTILITY LINES
- EXISTING GAS UTILITY LINES & VALVES & MARKERS
- EXISTING WATER UTILITY LINES & HYDRANTS
- EXISTING SANITARY SEWER UTILITY LINES & MANHOLES
- EXISTING MISCELLANEOUS UTILITY MANHOLES
- EXISTING FENCE LINES
- EXISTING RAILROAD LINE
- EXISTING ORES WETLAND BUFFERS 100'
- EXISTING STREAM CENTERLINES & EMBANKMENTS
- ENVIRONMENTALLY SENSITIVE AREA
- EXISTING KARST FEATURE MARKER, AREA & BUFFER AREA
- EXISTING WETLAND (NO ANTICIPATED STATE OR FEDERAL JURISDICTION) & WETLAND CONTINUES (ORANGE LINE)
- EXISTING WETLAND (STATE JURISDICTION) & WETLAND CONTINUES (ORANGE LINE)
- EXISTING WETLAND (ANTICIPATED USACE JURISDICTION) & WETLAND CONTINUES (ORANGE LINE)
- EXISTING POND
- 720 — EXISTING MAJOR CONTOUR
- 719 — EXISTING MINOR CONTOUR

NOTE, ISOLATED TREES AND UPLAND GRUBBING (THROUGH COORDINATION WITH ENV. MONITOR) MAY EXIST OUTSIDE OF SPECIFIED TREE CLEARING LOCATIONS BUT WITHIN THE LIMIT OF DISTURBANCE (LOD), THE CONTRACTOR IS TO REVIEW THE ENTIRE LOD TO ENSURE ALL TREES GREATER THAN 3-INCHES IN BREAST DIAMETER HEIGHT ARE REMOVED PRIOR TO MARCH 31 IN AN EFFORT TO AVOID TREE CLEARING RESTRICTIONS, ISOLATED TREES ARE ANTICIPATED TO BE HAND FELLED AND LEFT IN PLACE UNLESS EQUIPMENT IS ABLE TO ACCESS THESE LOCATIONS WITHOUT ADVERSE IMPACT.

Dig Safely. Call 811 Before You Dig

aes
2180 South 1300 East, Suite 600
Salt Lake City, UT 84106-2749
(801) 679 - 3500


TRC
249 Western Avenue
Augusta, ME 04330

PE STAMP:

STATE OF NEW YORK · DANIEL T. BUTNER · 079806 · LICENSED PROFESSIONAL ENGINEER

UNDER NEW YORK STATE EDUCATION LAW ARTICLE 145 (ENGINEERING), SECTION 7209, IT IS A VIOLATION OF THE LAW FOR ANY PERSON, UNLESS ACTING UNDER THE DIRECTION OF A LICENSED PROFESSIONAL ENGINEER, TO ALTER THIS DOCUMENT.

KEY PLAN:

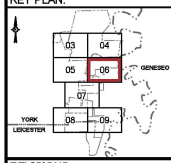

REVISIONS:

	DATE	DESCRIPTION
E	04/08/2026	ISSUED FOR REVIEW
F	04/16/2026	ISSUED FOR REVIEW
G	04/29/2026	ISSUED FOR REVIEW
H	09/11/2026	ADDED LAYDOWN YARD
I	09/16/2026	ADDED SEDIMENT PONDS
J	09/21/2026	REVISED PER CLIENT COMMENTS
K	10/05/2026	ADDED REVISION CLOUDS
L	10/22/2026	ADDED OCSF AROUND ESAs

PROJECT TITLE:

WHITE CREEK SOLAR

PROJECT LOCATION:

TOWN OF YORK &
TOWN OF LEICESTER
LIVINGSTON COUNTY
NEW YORK

SHEET TITLE & DESCRIPTION:

EXISTING CONDITIONS & TREE CLEARING PLAN (4)

ISSUED FOR CONSTRUCTION


PROJ. NUM:	666563
DES:	TRC
DWN:	TRC
CHK:	SGL
APV:	-
DATE:	09/08/2025

SCALE AT 22" x 34":

0 100' 200' 300' 400'

1" = 200'

SHEET NO:	REV:
TCP-06	L

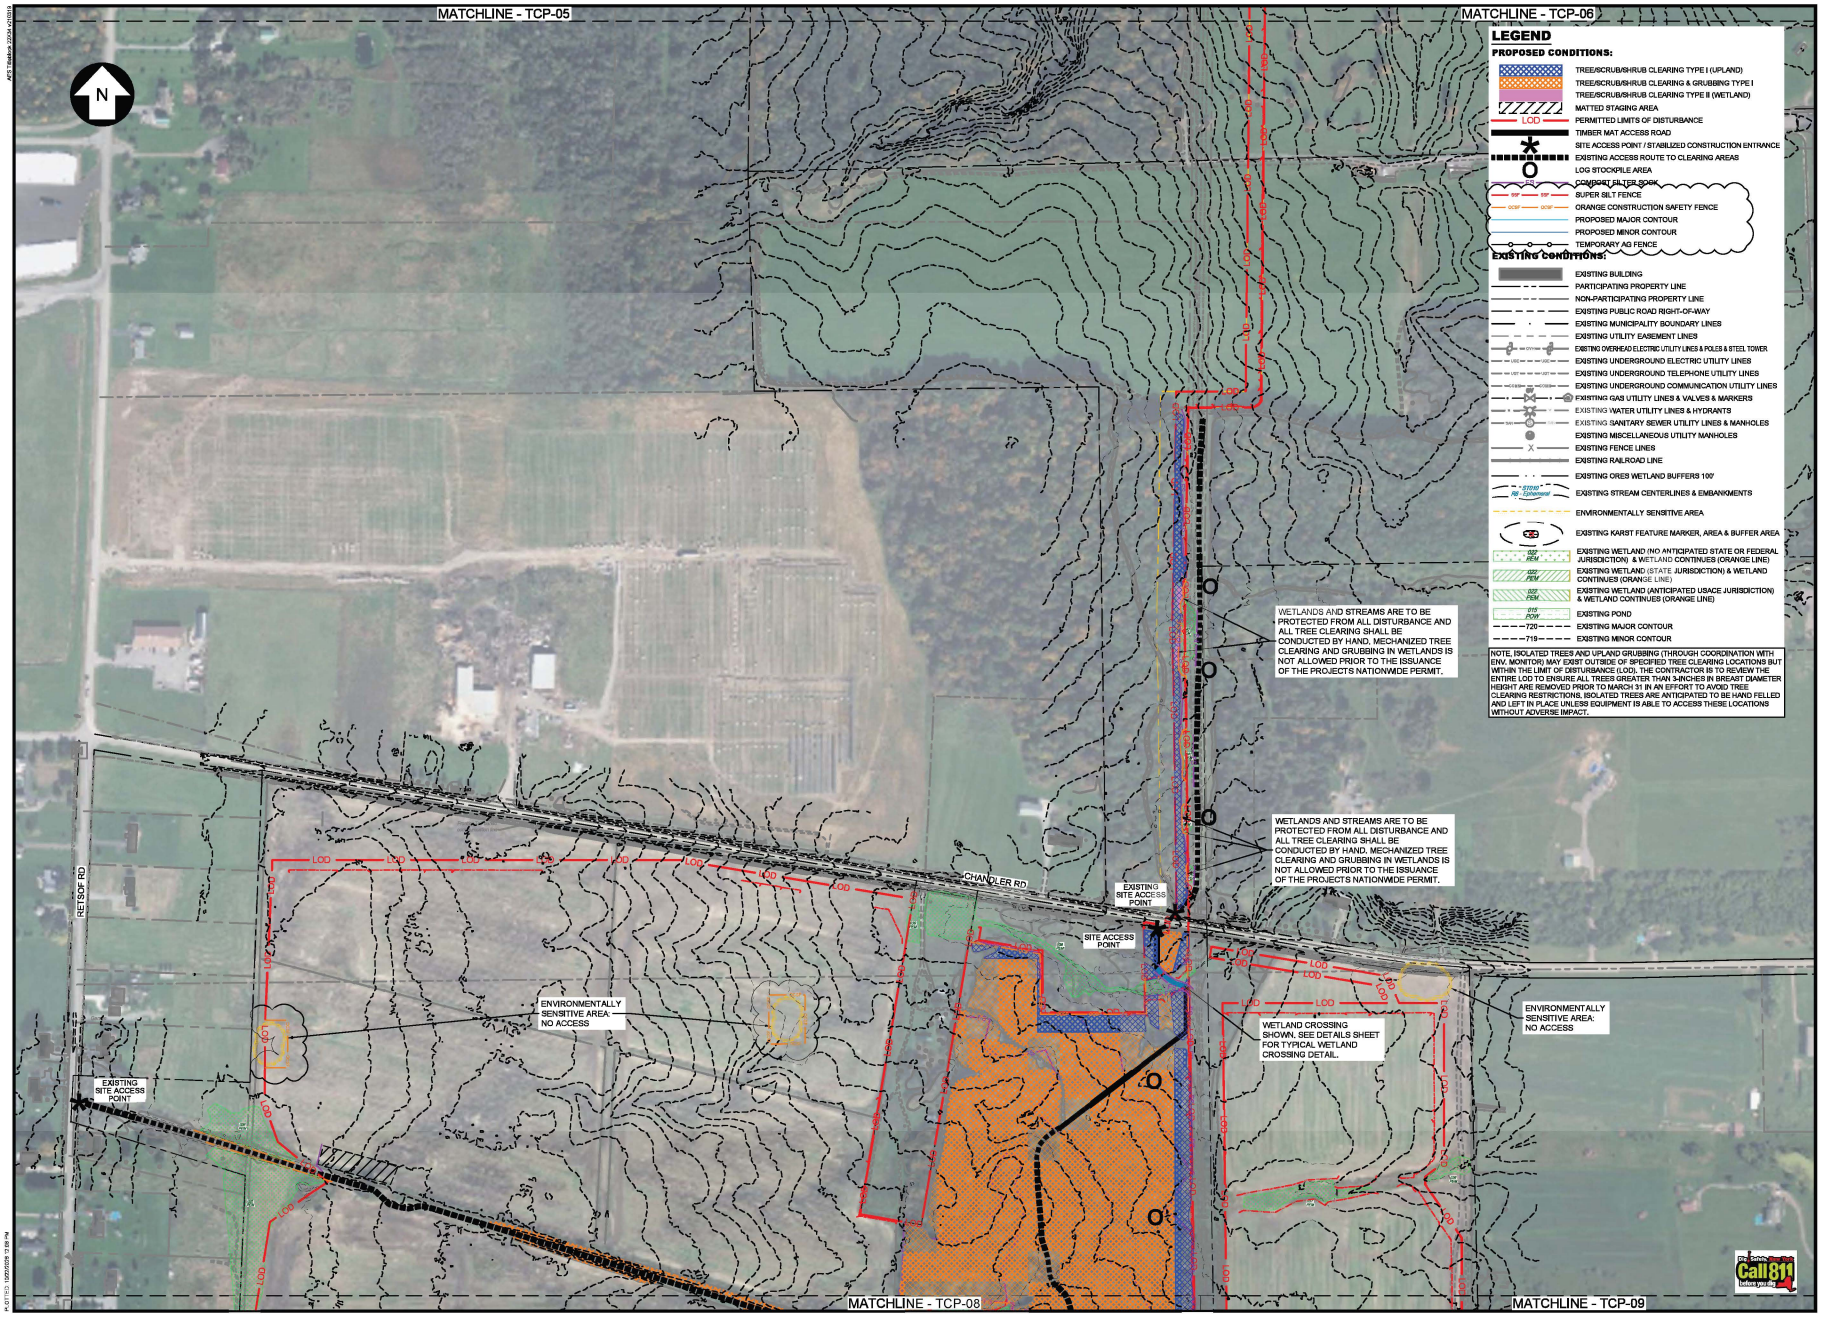

aes
2180 South 1300 East, Suite 600
Salt Lake City, UT 84106-2749
(801) 679 - 3500


TRC
249 Western Avenue
Augusta, ME 04330

PE STAMP:



UNDER NEW YORK STATE EDUCATION LAW ARTICLE 145 (ENGINEERING), SECTION 7209 (2) DESCRIPTION OF THE LAW FOR ANY PERSON, UNLESS ACTING UNDER THE DIRECTION OF A LICENSED PROFESSIONAL ENGINEER, TO ALTER THIS DOCUMENT.

KEY PLAN:

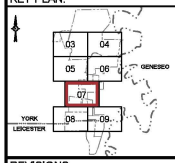

REVISIONS:

	DATE	DESCRIPTION
E	04/08/2026	ISSUED FOR REVIEW
F	04/16/2026	ISSUED FOR REVIEW
G	04/29/2026	ISSUED FOR REVIEW
H	09/11/2026	ADDED LAYDOWN YARD
I	09/16/2026	ADDED SEDIMENT PONDS
J	09/21/2026	REVISED PER CLIENT COMMENTS
K	10/05/2026	ADDED REVISION CLOUDS
L	10/22/2026	ADDED OCSF AROUND ESAs

PROJECT TITLE:

WHITE CREEK SOLAR

PROJECT LOCATION:

TOWN OF YORK & TOWN OF LEICESTER LIVINGSTON COUNTY NEW YORK

SHEET TITLE & DESCRIPTION:

EXISTING CONDITIONS & TREE CLEARING PLAN (5)

ISSUED FOR CONSTRUCTION


PROJ. NUM:	666563
DES:	TRC
DWN:	TRC
CHK:	SGL
APV:	-
DATE:	09/08/2025

SCALE AT 22" x 34":

0 100' 200' 300' 400'

1" = 200'

SHEET NO:	REV:
TCP-07	L

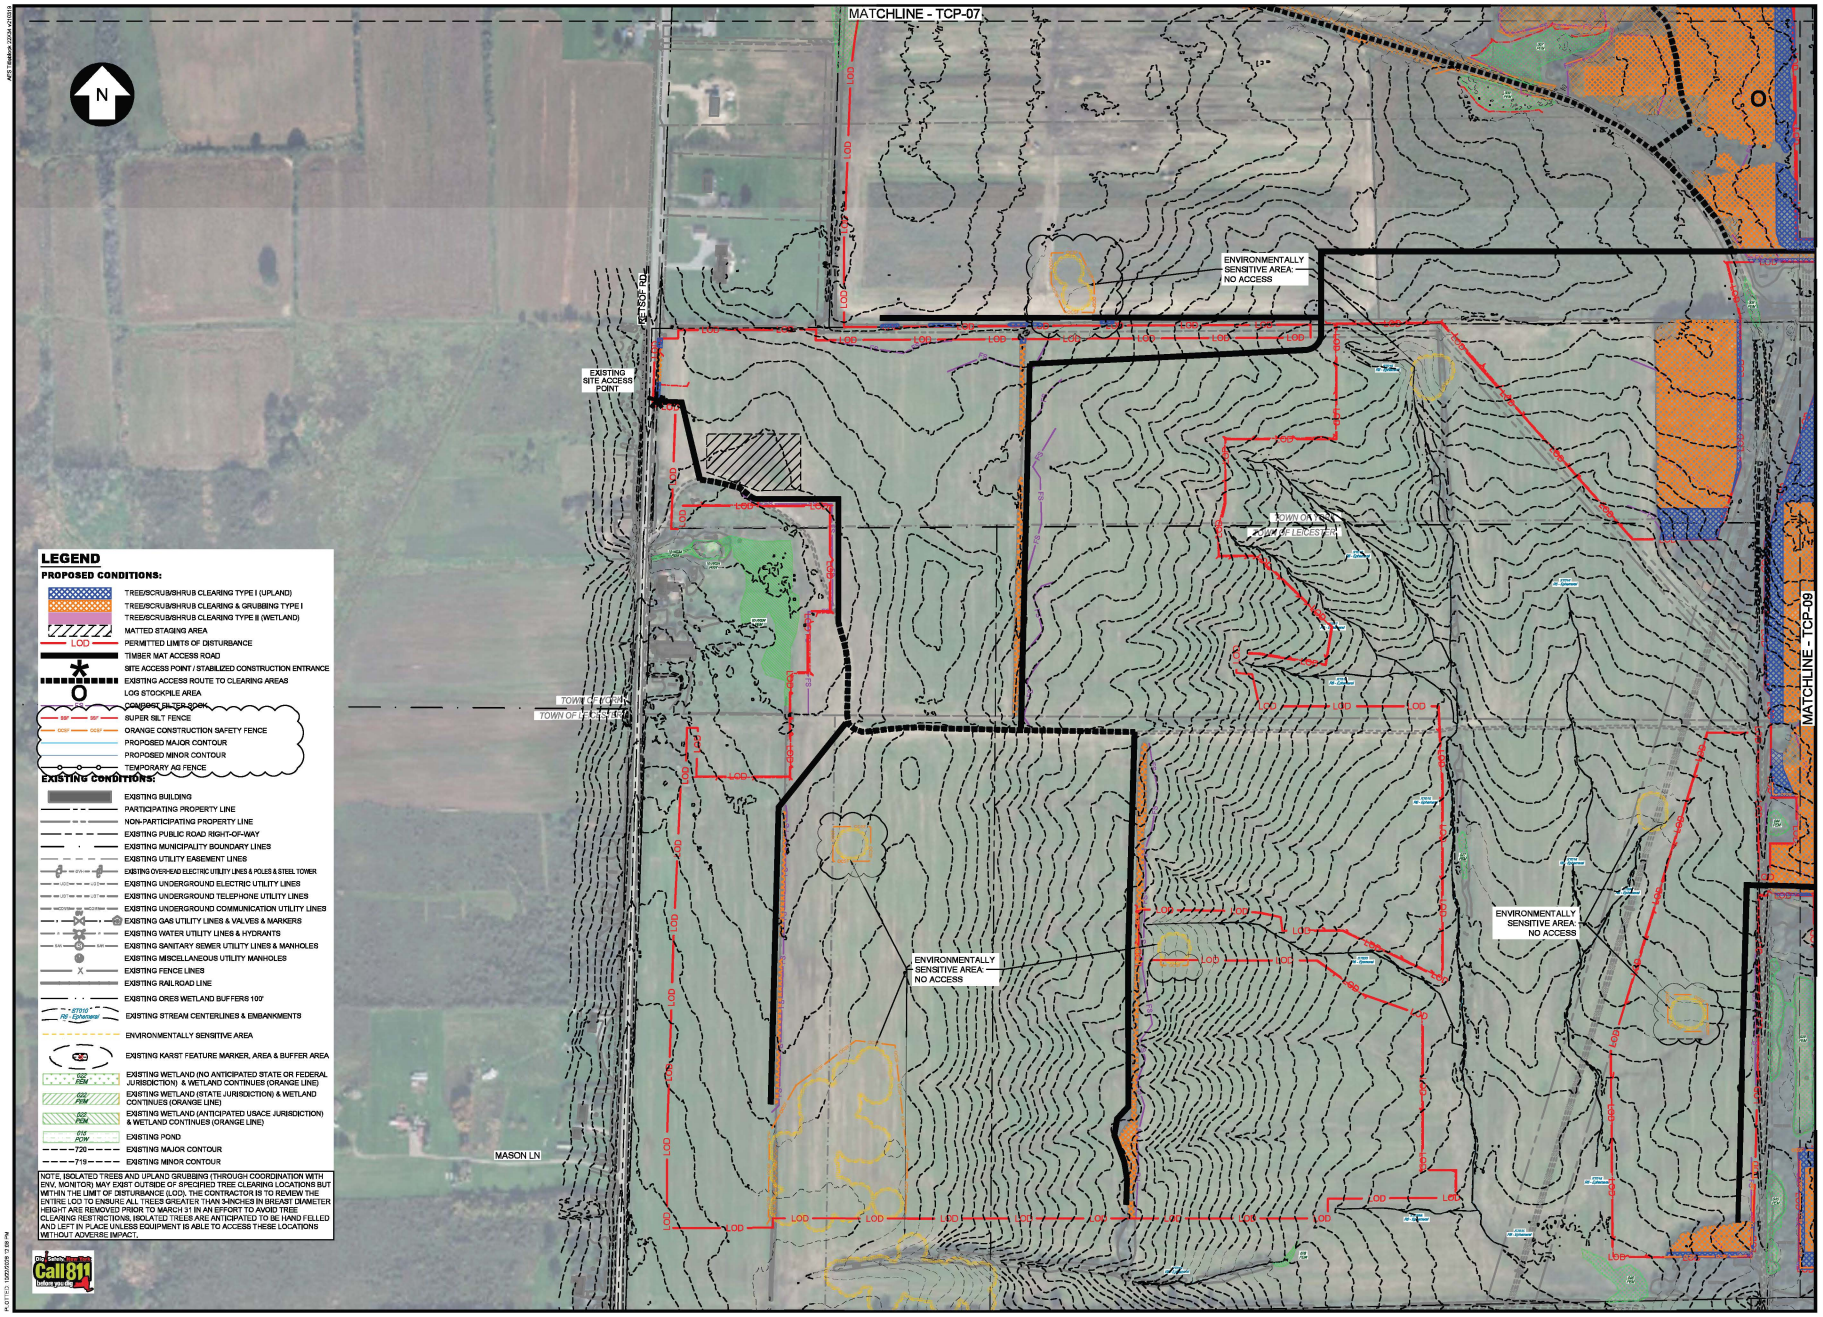

aes
2180 South 1300 East, Suite 600
Salt Lake City, UT 84106-2749
(801) 679 - 3500


TRC
249 Western Avenue
Augusta, ME 04330

PE STAMP:



UNDER NEW YORK STATE EDUCATION LAW ARTICLE 145 (ENGINEERING), SECTION 7209 IT IS A VIOLATION OF THE LAW FOR ANY PERSON, UNLESS ACTING UNDER THE DIRECTION OF A LICENSED PROFESSIONAL ENGINEER, TO ALTER THIS DOCUMENT.

KEY PLAN:

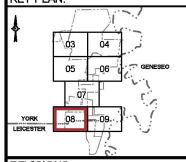

REVISIONS:

	DATE	DESCRIPTION
E	04/08/2026	ISSUED FOR REVIEW
F	04/16/2026	ISSUED FOR REVIEW
G	04/29/2026	ISSUED FOR REVIEW
H	09/11/2026	ADDED LAYDOWN YARD
I	09/16/2026	ADDED SEDIMENT PONDS
J	09/21/2026	REVISED PER CLIENT COMMENTS
K	10/05/2026	ADDED REVISION CLOUDS
L	10/22/2026	ADDED OCSF AROUND ESAs

PROJECT TITLE:

WHITE CREEK SOLAR

PROJECT LOCATION:

TOWN OF YORK &
TOWN OF LEICESTER
LIVINGSTON COUNTY
NEW YORK

SHEET TITLE & DESCRIPTION:

EXISTING CONDITIONS & TREE CLEARING PLAN (6)

ISSUED FOR CONSTRUCTION

PROJ. NUM:	666563
DES:	TRC
DWN:	TRC
CHK:	SGL
APV:	-
DATE:	09/08/2025

SCALE AT 22" x 34":
0 100' 200' 300' 400'
1" = 200'

SHEET NO: TCP-08
REV: L